

MARION
 B 25
 10/75
 Flog # 83

MISSISSIPPI
 BOARD OF WATER COMMISSIONERS
 416 North State Street
 Jackson, Mississippi 39201

CODED

WATER WELL DRILLERS LOG

1975 GRINER DRILLING SERVICE MARION

date well completed

firm name

county well located

LANDOWNER: ROSS WATER
ASSOCIATION, well no. 2
(south well)
 (mailing address)

description of formations encountered	from	to
TOP SOIL	0	3
SAND + Gravel	3	24
CLAY	24	60
SAND + gen Gravel	60	122
CLAY	122	142
SAND	142	152

WELL LOCATION: SW 1/4 SW 1/4 NW 1/4
 sec. 26 T. 5 N. R. 19 E.
 S. W.


miles of _____
 (distance) (direction) (nearest town)

WELL PURPOSE:
 (home, irrigation, municipal, industrial)

WELL COMPLETION DATA:

- (1) diameter (inches) 10 3/4"
- (2) total depth (feet) 124'
- (3) static water level (feet) 59' below above top of ground.
- (4) casing B.F., 82'
 (material) (depth)
10 3/4" if telescope see back.
 (size)
- (5) screen 30', 94'
 (length) (depth to top)
6" (.016) 304 S.S.
 (size) (material)
- (6) pump 10, 2000 197
 (HP) (yield.gpm)
Elect.
 (type power)
- (7) electric log Yes
 (yes or no)
MGS
 (organization running log)

CODED

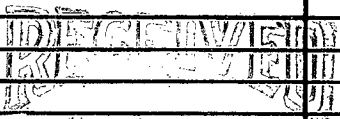

NOV 9 1975

(8) how well bottom plugged BACK
WASH VALVE

DRILLERS REMARKS: 5' stringer
on bottom of screen

WATER CONTROL

