

MARION
B 26
2/26/78

MISSISSIPPI
BOARD OF WATER COMMISSIONERS
416 North State Street
Jackson, Mississippi 39201

CODED

WATER WELL DRILLERS LOG

2/26/78 19 Grinner Drilling Service Marion Co.
date well completed firm name county well located

LANDOWNER: Florida Gas
John Q Barnes #1
Newsom field
(mailing address)

description of formations encountered	from	to
Streaked Sand	105	105
Gravel Clay	105	126
Clay + Sand	126	147
Sand Pea Gravel	147	231
Sand Clay	231	260

WELL LOCATION:
sec. 32 T. 5 (N) R. 19 E
1890' N + 1500' E of SW corner of Cross
miles (distance) of (direction) of (nearest town)

WELL PURPOSE: Oil Well Supply
(home, irrigation, municipal, industrial)

- WELL COMPLETION DATA:
- (1) diameter (inches) 3
 - (2) total depth (feet) 260
 - (3) static water level (feet) 0 below above top of ground.
 - (4) casing Steel, 231' (material), (depth)
3" (size) if telescope see back.
 - (5) screen 42' / 189' (length), (depth to top)
3' (size), Perforated Pipe (material)
 - (6) pump — 100 (HP), (yield gpm)
A.C. (type power)
 - (7) electric log NO (yes or no)
NA (organization running log)
 - (8) how well bottom plugged Orange
Peel


DRILLERS REMARKS:

RECEIVED
MAR 30 1978

MISS. Bd. OF WATER COMMISSIONERS

If well telescopes please sketch and show depths.

GROUND LEVEL

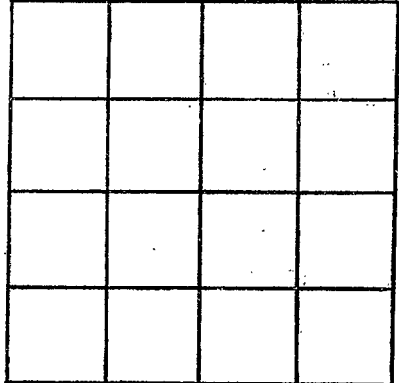

SECTION _____

Please indicate well location X.

ADDITIONAL INFORMATION

A series of horizontal lines for recording additional information.

If more than one screen, show locations of each on sketch.