

MARION
B 27
5/31/78

MISSISSIPPI
BOARD OF WATER COMMISSIONERS
416 North State Street
Jackson, Mississippi 39201

CODED

WATER WELL DRILLERS LOG
TOM GRIFFITH

PLUMBING & WELL SERVICE, INC.

Mississippi

May 31 19 78
date well completed

320 WATSON AVE.
COLUMBIA, MS 39423

county well located

LANDOWNER: *Wright Frutkin*

Rt. 4 - Box 500
Columbia, Miss.
(mailing address)

description of formations encountered

from to

<i>top soil</i>	0	2
<i>clay</i>	2	10
<i>sand</i>	10	100
<i>clay</i>	100	150
<i>gravel</i>	150	200
<i>clay</i>	200	630
<i>fine sand</i>	630	766

WELL LOCATION:

sec. 34 T 50 N R 19 E
S 1 miles W of Ston
(distance) (direction) (nearest town)

WELL PURPOSE: *Fish Pond*
(home, irrigation, municipal, industrial)

WELL COMPLETION DATA:

- (1) diameter (inches) 2" Flow
- (2) total depth (feet) 766' Well
- (3) static water level (feet) flow below above top of ground.
- (4) casing sch 40 pvc
(material) (depth)
- n/a if telescope see back.
(size)
- (5) screen 15' 75'
(length) (depth to top)
- 2" SS Johnson
(size) (material)
- (6) pump n/a
(HP) (yield gpm)
- (type power)
- (7) electric log no
(yes or no)
- (organization running log)
- (8) how well bottom plugged BW


CODED

DRILLERS REMARKS:

*Antennium
strat. here is weak.
2" well flowing approx
10 gpm*

If well telescopes please sketch and show depths.

GROUND LEVEL

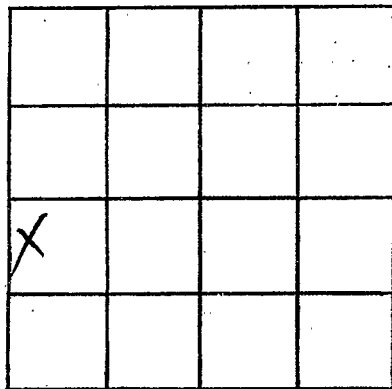

SECTION 34

Please indicate well location X.

ADDITIONAL INFORMATION

If more than one screen, show locations of each on sketch.