

MARION
B28
3/1/79

MISSISSIPPI
BOARD OF WATER COMMISSIONERS
416 North State Street
Jackson, Mississippi 39201

CODED

WATER WELL DRILLERS LOG

3/1 1979 Hollinger Well S. Marion
date well completed firm name county well located

LANDOWNER: Jim Callender
2nd street Callender
Columbia MS
(mailing address)

description of formations encountered	from	to
sand, gravel	0	80
clay	80	190
sand	190	260
clay	260	490
sand	490	550

WELL LOCATION:
sec. 30 T 5 N R 19 E
6 miles NW of Goss
(distance) (direction) (nearest town)

WELL PURPOSE:
(home, irrigation, municipal, industrial)

WELL COMPLETION DATA:

(1) diameter (inches) 2"

(2) total depth (feet) 550

(3) static water level (feet) flow below top of ground.

(4) casing 2" (material) 530 (depth)

if telescope see back.
(size)

(5) screen 20 (length) 530 (depth to top)

2" (size) PVC (material)

(6) pump NONE (HP) 30 (yield gpm)

NONE (type power)

(7) electric log (yes or no)

(organization running log)

(8) how well bottom plugged BALL FLOAT

DRILLERS REMARKS: Very Good


Miss. Board of Water Comm.

MAR 6 - 1979

RECEIVED

If well telescopes please sketch and show depths.

GROUND LEVEL

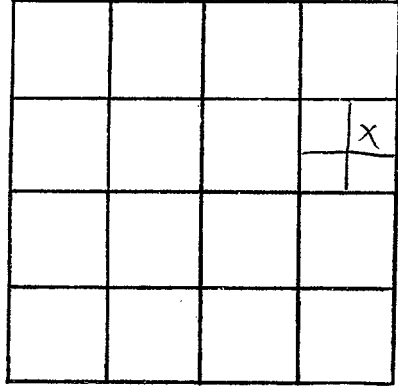

SECTION 30

Please indicate well location X.

ADDITIONAL INFORMATION

If more than one screen,
show locations of each on sketch.