

MARION
 B29
 10-11-79

MISSISSIPPI
 BOARD OF WATER COMMISSIONERS
 416 North State Street
 Jackson, Mississippi 39201

CODED

WATER WELL DRILLERS LOG

10-11-79 Griner Drilling Marion

date well completed

firm name

county well located

LANDOWNER:

Getty Orl
 P.O. Box 16898
 Mobile, Ala. 36616
 (mailing address)

description of formations encountered

from to

clay + pea gravel 0 10

WELL LOCATION:

1980' N + 1980' E
 Greens ck. sec. 28 T 5 N R 19 of
 Field NW of Goss SWICOR
 (distance) (direction) (nearest town)

sand + pea gravel 10 240

WELL PURPOSE:

oil field supply
 (home, irrigation, municipal, industrial)

WELL COMPLETION DATA:

- (1) diameter (inches) 3"
- (2) total depth (feet) 240'
- (3) static water level (feet) 40' ^{below} _{above} top of ground
- (4) casing Steel 231'
 (material) (depth)
 3" (size) if telescope see back.
- (5) screen 42' 189'
 (length) (depth to top)
 3" perforated (size) (material)
- (6) pump — 80
 (HP) (yield gpm)
 AC (type power)
- (7) electric log —
 (yes or no)
 (organization running log)

(8) how well bottom plugged

orange
 feet

DRILLERS REMARKS:


DEPT. OF NATURAL RESOURCES
 BUREAU OF LAND & WATER RESOURCES

NOV 13 1979

RECEIVED

If well telescopes please
sketch and show depths.

GROUND LEVEL

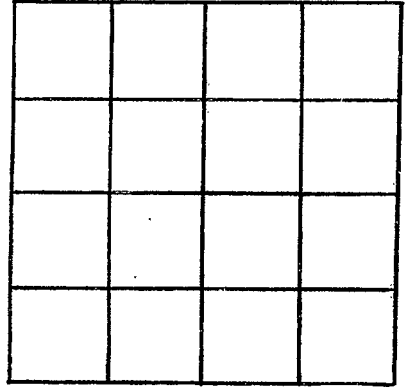

SECTION _____

Please indicate well location X.

ADDITIONAL INFORMATION

If more than one screen,
show locations of each on sketch.