

MARION
B-30
12-26-79

MISSISSIPPI
 BOARD OF WATER COMMISSIONERS
 416 North State Street
 Jackson, Mississippi 39201

CODED

WATER WELL DRILLERS LOG

12-26-79 Griner Drilling Marion
 date well completed firm name county well located

LANDOWNER:

Larco Drilling
1700 Capital Towers
JACKSON, MS
 (mailing address)

description of formations encountered

from to

clay, sand, gravel 0 35
sand + gravel 35 203

WELL LOCATION:

1980'S + 1980'E
sec 33 T 50 N R 14 E of
33-6 GOSS, MS NW 1/4
 (distance) (direction) (nearest town)

WELL PURPOSE: oil field
 (home, irrigation, municipal, industrial)

WELL COMPLETION DATA:

- (1) diameter (inches) 3"
- (2) total depth (feet) 203'
- (3) static water level (feet) 40' below above top of ground.
- (4) casing Steel 189'
 (material) (depth)
3" if telescope see back.
 (size)
- (5) screen 42' 144'
 (length) (depth to top)
3" perforated
 (size) (material)
- (6) pump 80
 (HP) (yield gpm)
AC
 (type power)
- (7) electric log
 (yes or no)
 (organization running log)

(8) how well bottom plugged orange
peel

DRILLERS REMARKS:


DEPT. OF NATURAL RESOURCES
 BUREAU OF LAND & WATER RESOURCES

JAN 24 1980

RECEIVED

If well telescopes please sketch and show depths.

GROUND LEVEL

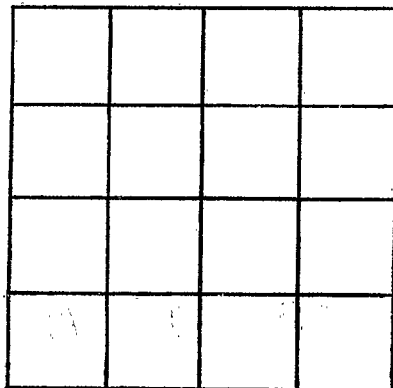

SECTION _____

Please indicate well location X.

ADDITIONAL INFORMATION

If more than one screen,
show locations of each on sketch.