

MARION
B 31
6/17/80

MISSISSIPPI
 BOARD OF WATER COMMISSIONERS
 416 North State Street
 Jackson, Mississippi 39201

WATER WELL DRILLERS LOG

6-17-80 *Trimer Drilling* *Marion*
 date well completed firm name county well located

LANDOWNER:
Petty Oil Corp.
P.O. Box 16878
Mobile, Alabama
 (mailing address)

description of formations encountered	from	to
<i>clay and sand</i>	<i>0</i>	<i>79</i>
<i>clay</i>	<i>79</i>	<i>140</i>
<i>sand and gravel</i>	<i>140</i>	<i>308</i>
<i>sand</i>	<i>308</i>	<i>329</i>
<i>sand and clay</i>	<i>329</i>	<i>350</i>

WELL LOCATION: *1500' N + 1500' W*
20' T 50' S R 19' E of
20-9 *Loss* *Disc/col*
 (distance) (direction) (nearest town)

WELL PURPOSE: *outfield*
 (home, irrigation, municipal, industrial)

WELL COMPLETION DATA:

(1) diameter (inches) *3"*

(2) total depth (feet) *350'*

(3) static water level (feet) *75'* *below* *above* top of ground.

(4) casing *steel, 336'*
 (material) (depth)

3"
 (size) If telescope see back.

(5) screen *42'*, *294'*
 (length) (depth to top)

3", *perforated*
 (size) (material)

(6) pump *80*
 (HP) (yield gpm)

AC
 (type power)

(7) electric log *-*
 (yes or no)

-
 (organization running log)

(8) how well bottom plugged *orange*
peel


DRILLERS REMARKS:

DEPT. OF NATURAL RESOURCES
 BUREAU OF LAND & WATER RESOURCES

JUN 26 1980
 RECEIVED

If well telescopes please sketch and show depths.

GROUND LEVEL

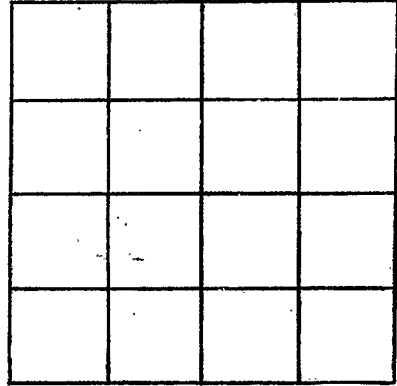

SECTION _____

Please indicate well location X.

ADDITIONAL INFORMATION

If more than one screen,
show locations of each on sketch.