

MARION

B-32
7-8-80

MISSISSIPPI
BOARD OF WATER COMMISSIONERS
416 North State Street
Jackson, Mississippi 39201

CODED

WATER WELL DRILLERS LOG

7-8 1980 *Lance Drilling Service* *Marion*
 date well completed firm name county well located

LANDOWNER:
Lance Drilling
1700 Capital Towers
Jackson, Ms 39205
 (mailing address)

description of formations encountered	from	to
<i>Clay and sand</i>	<i>0</i>	<i>21</i>
<i>sand and gravel</i>	<i>21</i>	<i>231</i>

WELL LOCATION: *1500' N + 1820' E*
34-5 *R-19* of *Yoss*
34-11 miles (distance) (direction) of (nearest town)

WELL PURPOSE:
 (home, irrigation, municipal, industrial)

- WELL COMPLETION DATA:
- (1) diameter (inches) 3"
 - (2) total depth (feet) 231'
 - (3) static water level (feet) 30 ^{Below} _{above} top of ground.
 - (4) casing steel, 189'
 (material) (depth)
3"
 (size) if telescope see back.
 - (5) screen 42' 147'
 (length) (depth to top)
3" perforated
 (size) (material)
 - (6) pump — 75
 (HP) (yield gpm)
ac
 (type power)
 - (7) electric log —
 (yes or no)
 (organization running log)
 - (8) how well bottom plugged orange
peel

CODED


DEPT. OF NATURAL RESOURCES
 BUREAU OF LAND & WATER RESOURCES

JUL 14 1980
 RECEIVED

DRILLERS REMARKS:

If well telescopes please
sketch and show depths.

GROUND LEVEL

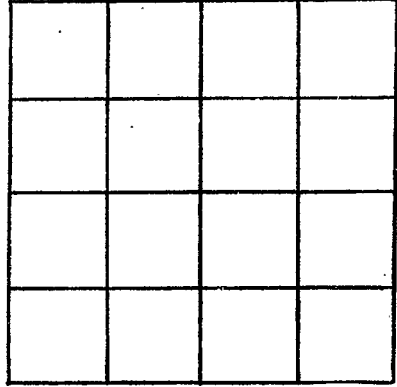

SECTION _____

Please indicate well location X.

ADDITIONAL INFORMATION

If more than one screen,
show locations of each on sketch.