

MARION  
B 33  
10/2/80

MISSISSIPPI  
BOARD OF WATER COMMISSIONERS  
416 North State Street  
Jackson, Mississippi 39201

CODED

WATER WELL DRILLERS LOG

*Spiner Drilling Service, Inc*  
firm name

*Marion*  
county well located

*10-2-80*  
date well completed

LANDOWNER:  
*Getty Oil Corporation*  
*P.O. Box 16878*  
*Mobile, Ala. 36616*  
(mailing address)

description of formations encountered

from to

*gravel*

*0 273*

WELL LOCATION: *660' N + 1980' E*

sec. *28* T. *5* N R. *19* E of *SW 100'*

*Foreign Greens Creek*  
distance (miles) *1.4* (direction) *Field* (nearest town)

WELL PURPOSE: *oil field supply*  
(home, irrigation, municipal, industrial)

CODED

WELL COMPLETION DATA:

(1) diameter (inches) *4"*

(2) total depth (feet) *273'*

(3) static water level (feet) *45'* *below* top of ground.

(4) casing *steel, 252'*  
(material) (depth)

*4"*  
(size) if telescope see back.

(5) screen *42'*, *210'*  
(length) (depth to top)

*4"*, *perforated*  
(size) (material)

(6) pump *-*, *80-100*  
(HP) (yield gpm)

*ac*  
(type power)

(7) electric log *-*  
(yes or no)

(organization running log)

(8) how well bottom plugged *orange*

DEPT. OF NATURAL RESOURCES  
BUREAU OF LAND & WATER RESOURCES


DRILLERS REMARKS:

OCT 23 1980

RECEIVED

If well telescopes please sketch and show depths.

GROUND LEVEL

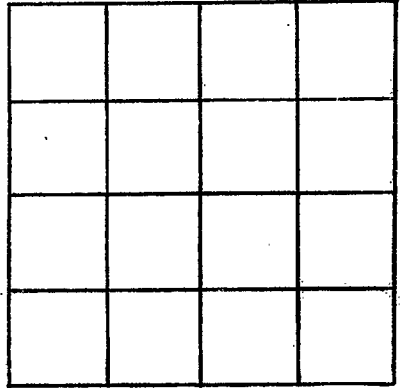

SECTION \_\_\_\_\_

Please indicate well location X.

ADDITIONAL INFORMATION

If more than one screen,  
show locations of each on sketch.