

MARION

R-34

11/15/80

MISSISSIPPI BOARD OF WATER COMMISSIONERS  
416 North State Street  
Jackson, Mississippi 39201

CODED

WATER WELL DRILLERS LOG

Griner Drilling Service, Inc

Marion

11-15-80 date well completed

Griner Drilling Service, Inc firm name

Marion county well located

LANDOWNER:

Getty Oil Corporation  
P.O. Box 16878  
Mobile, Ala. 36616  
(mailing address)

description of formations encountered

from

to

gravel

0

252

CODED

WELL LOCATION: 850' N 1756' E

NO 1 Dawson Unit 33 1/4 miles of 33 1/4 miles of  
33 T 5 N R 19 E of SW/4

WELL PURPOSE: oil field supply  
(home, irrigation, municipal, industrial)

WELL COMPLETION DATA:

- (1) diameter (inches) 4"
- (2) total depth (feet) 252'
- (3) static water level (feet) 50' below top of ground
- (4) casing steel, 231' (material) (depth)  
4" (size) If telescope see back.
- (5) screen 42' 189' (length) (depth to top)  
4" perforated (size) (material)
- (6) pump 100 (HP) (yield gpm)  
ac (type power)
- (7) electric log (yes or no)

(organization running log)


(8) how well bottom plugged orange  
peel

DRILLERS REMARKS:

DEPT. OF NATURAL RESOURCES  
BUREAU OF LAND & WATER RESOURCES  
NOV 25 1980  
RECEIVED

If well telescopes please sketch and show depths.

GROUND LEVEL

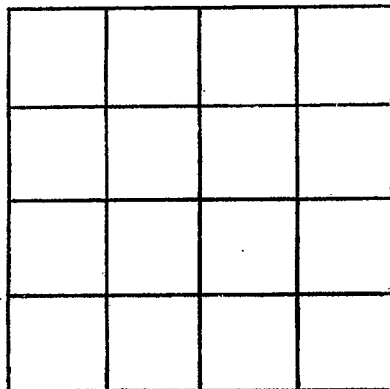

SECTION \_\_\_\_\_

Please indicate well location X.

ADDITIONAL INFORMATION

If more than one screen, show locations of each on sketch.