

MISSISSIPPI DEPARTMENT OF NATURAL RESOURCES

Bureau of Land and Water Resources

Southport Mall

P.O. Box 10631

Jackson, Mississippi 39209

WATER WELL DRILLERS LOG

CODED

MARION
B 35
1-20-81

Greene Drilling Service, Inc. Marion

date well completed

firm name

county well located

LANDOWNER:

Larce Drilling Co.
1700 Capital Towers
Jackson, Ms.
(mailing address)

description of formations encountered

from

to

gravel

0 231'

WELL LOCATION:

1600' N + 600' W
Sec. 20 T. 50 S. R. 19 E. of
Supp. 9 Greens Cr. Field
20-9 miles (distance) (direction) (nearest town)

WELL PURPOSE:

Oil field supply
(home, irrigation, municipal, industrial)

WELL COMPLETION DATA:

- (1) diameter (inches) 4"
- (2) total depth (feet) 231'
- (3) static water level (feet) 10' ^{below}/_{above} top of ground.
- (4) casing steel, 231' (material) (depth)
4" (size) If telescope see back.
- (5) screen 42', 189' (length) (depth to top)
4" perforated (size) (material)
- (6) pump — 80 (HP) (yield gpm)
ac (type power)
- (7) electric log — (yes or no)

(organization running log)

- (8) how well bottom plugged orange
peel

DRILLERS REMARKS:


DEPT. OF NATURAL RESOURCES
BUREAU OF LAND & WATER RESOURCES

JAN 26 1981

RECEIVED

If well telescopes please
sketch and show depths.

GROUND LEVEL

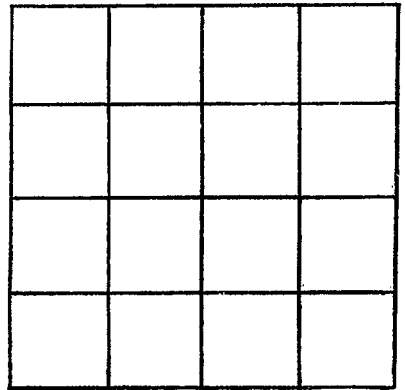

SECTION _____

Please indicate well location X.

ADDITIONAL INFORMATION

If more than one screen,
show locations of each on sketch.