

MARION
B36
5-29-81

MISSISSIPPI
BOARD OF WATER COMMISSIONERS
416 North State Street
Jackson, Mississippi 39201

WATER WELL DRILLERS LOG

CODED

5/29/81 date well completed 19 Tom Killeth firm name Marion county well located

LANDOWNER: NOI Newman
Florida, Gas
1114 Capital Avenue Jackson
(mailing address) Miss

| description of formations encountered | from | to |
|---------------------------------------|------------|------------|
| <u>Top soil</u> | <u>0</u> | <u>1</u> |
| <u>Sand</u> | <u>1</u> | <u>130</u> |
| <u>Clay</u> | <u>130</u> | <u>155</u> |
| <u>Hard</u> | <u>155</u> | <u>196</u> |

WELL LOCATION:
sec. 32 T-5 R-19
7 miles W of Harr
(distance) (direction) (nearest town)

625' N + 150' W of
SE Cor of Sec. 32

WELL PURPOSE: oil well
(home, irrigation, municipal, industrial)

- WELL COMPLETION DATA:
- (1) diameter (inches) 4"
 - (2) total depth (feet) 196
 - (3) static water level (feet) 156 below top of ground.
 - (4) casing steel (material) 156 (depth)
n/a (size) If telescope see back.
 - (5) screen 40 (length) 156 (depth to top)
4 (size) slat-slot (material)
 - (6) pump Air (HP) 50 gpm (yield gpm)
Compressor (type power)
 - (7) electric log no (yes or no)
n/a (organization running log)
 - (8) how well bottom plugged steel


CODED



DRILLERS REMARKS:

If well telescopes please sketch and show depths.

GROUND LEVEL

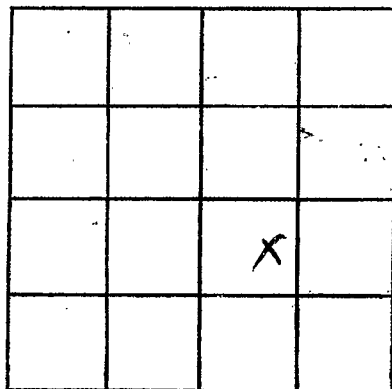

SECTION 5

Please indicate well location X.

ADDITIONAL INFORMATION

If more than one screen, show locations of each on sketch.