

MISSISSIPPI DEPARTMENT OF NATURAL RESOURCES

Bureau of Land and Water Resources

Southport Mall

P.O. Box 10631

CODED

Jackson, Mississippi 39209

WATER WELL DRILLERS LOG

Griner Drilling Service, Inc.

Marion

Marion
B 37
11-9-81

11-9-81  
date well completed

Griner Drilling Service, Inc.  
firm name

Marion  
county well located

LANDOWNER:	description of formations encountered	from	to
Florida Exploration 1444 Capital Towers Jackson, MS 39201 (mailing address)	clay	0	10
WELL LOCATION: 500' S, 500' W Sec. 29 T. 5 N R. 19 E OF Barnes Greens Creek Field (distance) (direction) (nearest town)	sand, gravel	10	84
	streaked	84	105
	sand, gravel	105	231
WELL PURPOSE: oil field supply (home, irrigation, municipal, industrial)			
WELL COMPLETION DATA:			
(1) diameter (inches) 4"			
(2) total depth (feet) 231'			
(3) static water level (feet) 10' below top of ground.			
(4) casing steel, 210' (material), (depth) 4" (size) if telescope see back.			
(5) screen 42' 168' (length), (depth to top) 4" perforated (size), (material)			
(6) pump - 95 (HP), (yield gpm) AC (type power)			
(7) electric log - (yes or no) (organization running log)			
(8) how well bottom plugged Orange peel			

CODED


DEPT. OF NATURAL RESOURCES  
BUREAU OF LAND & WATER RESOURCES

DEC - 9 1981  
RECEIVED

DRILLERS REMARKS:

If well telescopes please sketch and show depths.

GROUND LEVEL

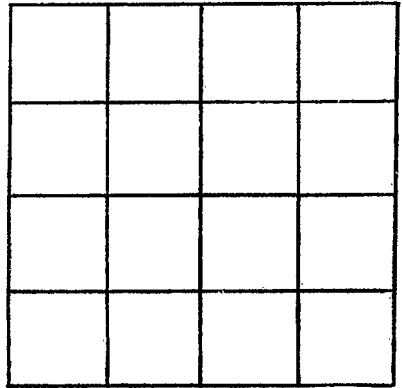

SECTION \_\_\_\_\_

Please indicate well location X.

ADDITIONAL INFORMATION

If more than one screen,  
show locations of each on sketch.