

MISSISSIPPI DEPARTMENT OF NATURAL RESOURCES

Bureau of Land and Water Resources

Southport Mall

P.O. Box 10631

Jackson, Mississippi 39209

WATER WELL DRILLERS LOG

TOM DRUMBING & WELL SERVICE, INC.

MARION
B 3 8
8/10/82
8/10

Marion Co. This

date well completed

firm name

county well located

LANDOWNER:

description of formations encountered

from

to

Tomlinson Interest

3201 Hardy St.

Hattiesburg, Miss 39401

(mailing address)

Top Soil

0

1

(Chalk)

1

5

Red Gravel

5

110

(Chalk)

110

140

Red Gravel

140

280

WELL LOCATION:

sec. 21 T 5 N R 19 E S


4 miles W of (Doss)

WELL PURPOSE: oil

WELL COMPLETION DATA:

- (1) diameter (inches) 4"
- (2) total depth (feet) 280
- (3) static water level (feet) 15' below top of ground.
- (4) casing Steel, 240' (material) (depth)
4" (size) if telescope see back.
- (5) screen 40' 240' (length) (depth to top)
4" Steel Slat (size) (material)
- (6) pump None 80 (HP) (yield gpm)
Electric (type power)
- (7) electric log No (yes or no)

660' N + 660' E of SW Cor. of Sec. 21

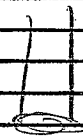

DEPT. OF NATURAL RESOURCES
BUREAU OF LAND & WATER RESOURCES

SEP 29 1982

RECEIVED


(organization running log) *Plugged*

(8) how well bottom plugged

DRILLERS REMARKS:

If well telescopes please sketch and show depths.

GROUND LEVEL

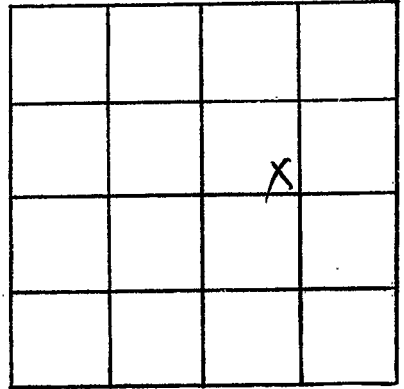

SECTION _____

Please indicate well location X.

ADDITIONAL INFORMATION

If more than one screen,
show locations of each on sketch.