

MISSISSIPPI DEPARTMENT OF NATURAL RESOURCES

Bureau of Land and Water Resources

Southport Mall

P.O. Box 10631

Jackson, Mississippi 39209

WATER WELL DRILLERS LOG

MARION
B 39
02101/83

02/01/83
date well completed

Loa Griffith & Sons
firm name

Marion
county well located


LANDOWNER:	description of formations encountered	from	to
Murco Drilling Corp 1908 Beck Building Shreveport, La 7101 (mailing address)	Chalk	0	3
	Sand & Gravel	3	25
	Chalk	25	25
	Red Gravel	25	250
	Chalk	210	256
WELL LOCATION: sec 34 T 50 N R 19 E S W 2 miles W of Goss (distance) (direction) (nearest town)	1500' N & 500' E of SW 1/4		
WELL PURPOSE: oil (home, irrigation, municipal, industrial)			
WELL COMPLETION DATA:			
(1) diameter (inches) 3"			
(2) total depth (feet) 250'			
(3) static water level (feet) 15' below top of ground.			
(4) casing Steel, 210' (material) (depth)			
N/A if telescope see back. (size)			
(5) screen 40', 210' (length) (depth to top)			
3", steel slot (size) (material)			
(6) pump none 85 (HP) (yield gpm)			
AIR LIFT (type power)			
(7) electric log NONE (yes or no)			
N/A (organization running log)			
(8) how well bottom plugged welded plugged			
DRILLERS REMARKS:			

CODED

DEPT. OF NATURAL RESOURCES
BUREAU OF LAND & WATER RESOURCES
FEB 22 1983
RECEIVED

If well telescopes please sketch and show depths.

GROUND LEVEL

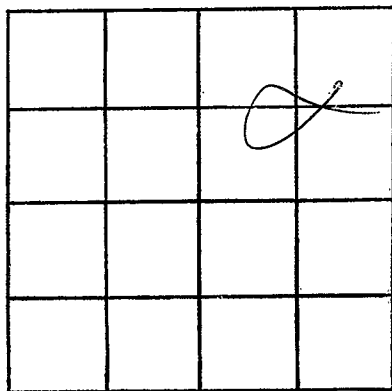

SECTION 34

Please indicate well location X.

ADDITIONAL INFORMATION

If more than one screen,
show locations of each on sketch.