

Marion
B 2000
6-75

MISSISSIPPI
BOARD OF WATER COMMISSIONERS
416 North State Street
Jackson, Mississippi 39201

WATER WELL DRILLERS LOG

June 25 1975 E.B. Sheward Marion
date well completed firm name county well located


LANDOWNER:	description of formations encountered	from	to
Harold Solar	GRAY CLAY	0	15'
Columbia, Ms. (mailing address)	SAND & GRAVEL	15	140'
WELL LOCATION: sec 30 T 5 N R 19 E 13V 39 miles NW of Columbia (distance) (direction) (nearest town)			
WELL PURPOSE: (home irrigation, municipal, industrial)			
WELL COMPLETION DATA:			
(1) diameter (inches) 2"			
(2) total depth (feet) 40'			
(3) static water level (feet) 18' below top of ground.			
(4) casing (material) pl. (depth) 35'			
2" (size) if telescope see back.			
(5) screen (length) 5' (depth to top)			
2" (size) pl. (material)			
(6) pump 1/3 (HP) 8 (yield gpm)			
E (type power)			
(7) electric log (yes or no)			
(organization running log)			
(8) how well bottom plugged BWV			
DRILLERS REMARKS:			

DEC - 5 1975

MISS. BU. OF WATER COMMISSIONERS

If well telescopes please sketch and show depths.

GROUND LEVEL

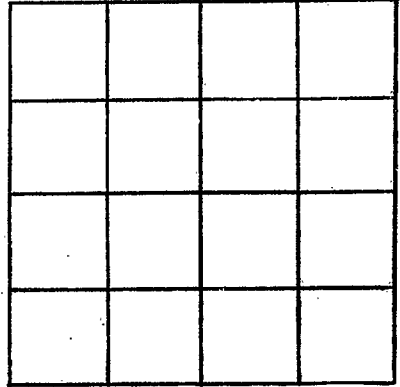

SECTION _____

Please indicate well location X.

ADDITIONAL INFORMATION

If more than one screen, show locations of each on sketch.