

Marion
B 2001
7-75

MISSISSIPPI
BOARD OF WATER COMMISSIONERS
416 North State Street
Jackson, Mississippi 39201

WATER WELL DRILLERS LOG

July 25 date well completed 1975 E.B. Sheppard firm name Marion county well located

LANDOWNER:
C. H. Creek
Columbia, Ms.
(mailing/address)

WELL LOCATION:
sec 36 T 5 N R 19 E 13W
5 miles N Columbia
(distance) (direction) (nearest town)

WELL PURPOSE:
(home, irrigation, municipal, industrial)

WELL COMPLETION DATA:

- (1) diameter (inches) 2"
- (2) total depth (feet) 260'
- (3) static water level (feet) 56' ^{below} top of ground.
- (4) casing pl. 250'
(material) (depth)
2" If telescope see back.
(size)
- (5) screen 10' 250'
(length) (depth to top)
- 2" pl.
(size) (material)
- (6) pump 1 8
(HP) (yield gpm)
E
(type power)
- (7) electric log (yes or no)
- (organization running log)
- (8) how well bottom plugged BWV


description of formations encountered	from to	
RED SANDY CLAY	0	18'
BLUE CLAY	18	200'
FINE SAND	200	240'
COARSE SAND & PEA GRAVEL MIXED	240	260'

DRILLERS REMARKS:

DECEMBER 1975
DEC - 5 1975
MISS. BD. OF WATER COMMISSIONERS

If well telescopes please sketch and show depths.

GROUND LEVEL

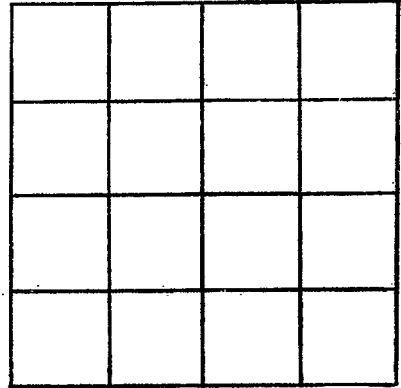

SECTION _____

Please indicate well location X.

ADDITIONAL INFORMATION

If more than one screen,
show locations of each on sketch.