

MARION
 B 2003
 5-22-78

MISSISSIPPI
 BOARD OF WATER COMMISSIONERS
 416 North State Street
 Jackson, Mississippi 39201

WATER WELL DRILLERS LOG
 TOM GRIFFITH

May 22 19 78
 date well completed
 BLUMBERG & WELL SERVICE, INC.
 firm name
 Marion
 county well located

LANDOWNER:
 John Eddie Stamps
 Rt. 4 Box 475 Columbia
 (mailing address) Miss.

description of formations encountered	from	to
top soil	0	1
clay sand	1	20
	20	100


WELL LOCATION:
 sec 27 T 50N R 17E
 2 miles N of Osan
 (distance) (direction) (nearest town)

WELL PURPOSE: home
 (home, irrigation, municipal, industrial)

- WELL COMPLETION DATA:
- (1) diameter (inches) 2"
 - (2) total depth (feet) 100 ft.
 - (3) static water level (feet) 110 ft. below top of ground.
 - (4) casing plaster 90 ft.
 (material) (depth)
 2" (size) if telescope see back.
 - (5) screen 10 ft. 90 ft.
 (length) (depth to top)
 2" plaster (size) (material)
 - (6) pump Rust 10
 (HP) (yield gpm)
 Electric (type power)
 - (7) electric log no
 (yes or no)

(organization running log)
 B W V


DRILLERS REMARKS:

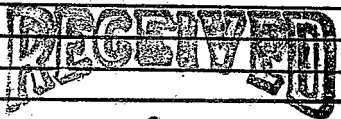

JUN 30 1978

If well telescopes please sketch and show depths.

GROUND LEVEL

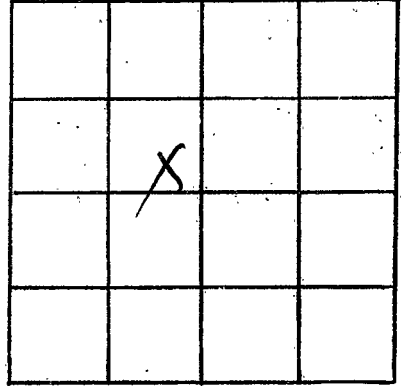

SECTION 27

Please indicate well location X.

ADDITIONAL INFORMATION

If more than one screen,
show locations of each on sketch.