

MARION  
 B 2005  
 10-8-80

MISSISSIPPI  
 BOARD OF WATER COMMISSIONERS  
 416 North State Street  
 Jackson, Mississippi 39201

WATER WELL DRILLERS LOG

10-8 19 80 Hollinger Marion  
 date well completed firm name county well located

LANDOWNER: Henry Hobbes  
Elm St.  
Columbia Ms.  
 (mailing address)

description of formations encountered	from to	
	feet	feet
Clay	0	30
Red sand, gravel	30	50
sand, gravel	50	87

WELL LOCATION:  
 sec. 19 T. 56 N. R. 19 E.  
 S. W. (W)  
4 miles W of Bunk Hill  
 (distance) (direction) (nearest town)

WELL PURPOSE: Home  
 (home, irrigation, municipal, industrial)

- WELL COMPLETION DATA:
- (1) diameter (inches) 2
  - (2) total depth (feet) 85
  - (3) static water level (feet) 30 below top of ground.
  - (4) casing pvc 80  
 (material) (depth)  
 (size) if telescope see back.
  - (5) screen 5 80  
 (length) (depth to top)  
2 pvc  
 (size) (material)
  - (6) pump 1 10  
 (HP) (yield gpm)  
elect  
 (type power)
  - (7) electric log             
 (yes or no)

(organization running log)  
 (8) how well bottom plugged sand  
SHANK

DRILLERS REMARKS: good well


DEPT. OF NATURAL RESOURCES  
 BUREAU OF LAND & WATER RESOURCES

OCT 20 1980

RECEIVED

If well telescopes please sketch and show depths.

GROUND LEVEL

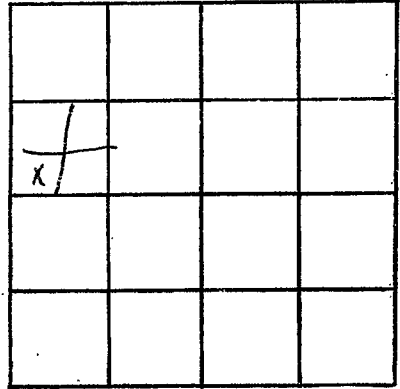

SECTION 19

Please indicate well location X.

ADDITIONAL INFORMATION

If more than one screen,  
show locations of each on sketch.