

Marion
B 2007
6-20-81

MISSISSIPPI
BOARD OF WATER COMMISSIONERS
416 North State Street
Jackson, Mississippi 39201

WATER WELL DRILLERS LOG

6-20 1981 Hollinger MARION
date well completed firm name county well located

LANDOWNER: Emily Lee Davis	description of formations encountered	from	to
RT1 Goss			
(mailing address)	SAND, gravel	0	35
	CLAY	35	100
	COARSE SAND	100	140

WELL LOCATION: S
sec. 37 T4N R17E
4 miles W of Goss
(distance) (direction) (nearest town)

WELL PURPOSE: Fish pond
(home, irrigation, municipal, industrial)


- WELL COMPLETION DATA:
- (1) diameter (inches) 2"
 - (2) total depth (feet) 140
 - (3) static water level (feet) 20 (below above top of ground)
 - (4) casing PVC 120
(material) (depth)
(size) if telescope see back.
 - (5) screen 20 120
(length) (depth to top)
2 PVC
(size) (material)
 - (6) pump No. (HP) 357040
(yield gpm)
elect
(type power)
 - (7) electric log (yes or no)
 - (organization running log)
 - (8) how well bottom plugged SAND
SHRUBS

DRILLERS REMARKS: Good well

DEPT. OF NATURAL RESOURCES
BUREAU OF LAND & WATER RESOURCES


AUG 26 1981

RECEIVED

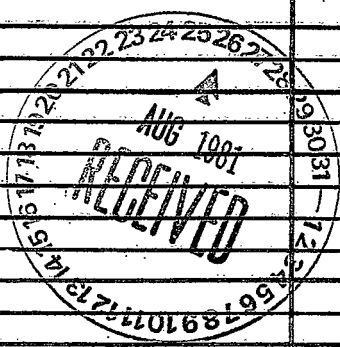

If well telescopes please sketch and show depths.

GROUND LEVEL

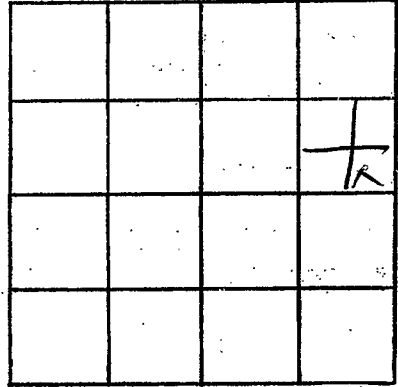

SECTION

32

Please indicate well location X.

ADDITIONAL INFORMATION

Multiple horizontal lines for additional information.

If more than one screen, show locations of each on sketch.