

MARION
B 2008
8-24-81

MISSISSIPPI
BOARD OF WATER COMMISSIONERS
416 North State Street
Jackson, Mississippi 39201

WATER WELL DRILLERS LOG

8-24-81 19 Tom Smith's Well Serv. Marion
date well completed firm name county well located

LANDOWNER: <u>Boyer Jones</u>	description of formations encountered	from	to
	top soil	0	3
	clay	3	12
	sand	12	36
WELL LOCATION: sec <u>33</u> T <u>S</u> N R <u>19</u> W <u>Northwest</u> miles <u>8</u> of <u>Columbia</u> (distance) (direction) (nearest town)			
WELL PURPOSE: <u>Home</u> (home, irrigation, municipal, industrial)			
WELL COMPLETION DATA:			
(1) diameter (inches) <u>2"</u>			
(2) total depth (feet) <u>36'</u>			
(3) static water level (feet) <u>17</u> below top of ground.			
(4) casing <u>plastic</u> <u>26</u> (material) (depth)			
(size) if telescope see back.			
(5) screen <u>10' net</u> <u>26</u> (length) (depth to top)			
<u>2 in</u> <u>plastic</u> (size) (material)			
(6) pump <u>1</u> <u>10</u> (HP) (yield gpm)			
<u>90cc</u> (type power)			
(7) electric log <u>no</u> (yes or no) <u>na</u> (organization running log)			
(8) how well bottom plugged <u>B, W, U</u>			
DRILLERS REMARKS:			


DEPT. OF NATURAL RESOURCES
BUREAU OF LAND & WATER RESOURCES

OCT 20 1981

RECEIVED

If well telescopes please sketch and show depths.

GROUND LEVEL

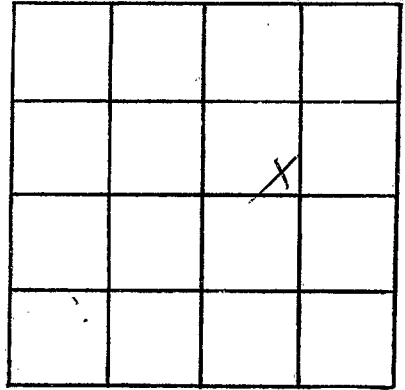

SECTION 33

Please indicate well location X.

ADDITIONAL INFORMATION

If more than one screen, show locations of each on sketch.