

MISSISSIPPI DEPARTMENT OF NATURAL RESOURCES

Bureau of Land and Water Resources

Southport Mall

P.O. Box 10631

Jackson, Mississippi 39209

WATER WELL DRILLERS LOG

Marion  
B  
2009

9-14 1982 Hollinger Marion  
 date well completed firm name county well located

LANDOWNER: Howard Howard  
RT 4 Box 454  
Columbia, MS  
 (mailing address)

description of formations encountered	from	to
<u>Sand, clay</u>	<u>0</u>	<u>10</u>
<u>Chalk, clay</u>	<u>10</u>	<u>30</u>
<u>Sand, pen gravel</u>	<u>30</u>	<u>40</u>

WELL LOCATION:  
 sec. 21 T. 5 (N) R. 19 E  
 miles 4 of Hathorn  
 (distance) (direction) (nearest town)

WELL PURPOSE:  
 (home, irrigation, municipal, industrial)

- WELL COMPLETION DATA:
- (1) diameter (inches) 2
  - (2) total depth (feet) 40
  - (3) static water level (feet) 15 below above top of ground.
  - (4) casing PVC 35  
 (material) (depth)  
 \_\_\_\_\_ if telescope see back.  
 (size)
  - (5) screen 5 35  
 (length) (depth to top)  
2 PVC  
 (size) (material)
  - (6) pump 1/2 6  
 (HP) (yield gpm)  
elect  
 (type power)
  - (7) electric log \_\_\_\_\_  
 (yes or no)  
 \_\_\_\_\_  
 (organization running log)

(8) how well bottom plugged sand  
SHALE

DRILLERS REMARKS: good


DEPT. OF NATURAL RESOURCES  
 BUREAU OF LAND & WATER RESOURCES

NOV 16 1982

RECEIVED

If well telescopes please sketch and show depths.

GROUND LEVEL

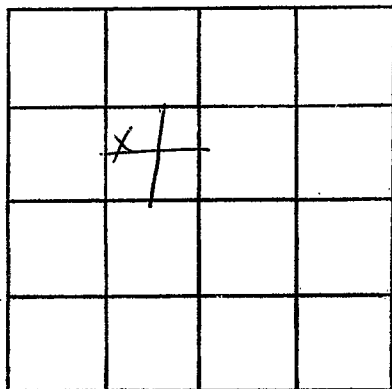

SECTION 21

Please indicate well location X.

ADDITIONAL INFORMATION

If more than one screen,  
show locations of each on sketch.