

MISSISSIPPI DEPARTMENT OF NATURAL RESOURCES

Bureau of Land and Water Resources

Southport Mall

P.O. Box 10631

Jackson, Mississippi 39209

WATER WELL DRILLERS LOG

Makion
B 2011

9-21 1983 Hollingsworth Makion
date well completed firm name county well located

LANDOWNER: Ronald Buckley
RT 4 Box 450
Columbia, MS
(mailing address)

description of formations encountered	from	to
<u>sand, clay</u>	<u>0</u>	<u>10</u>
<u>clay</u>	<u>10</u>	<u>40</u>
<u>sand, gravel</u>	<u>40</u>	<u>62</u>

WELL LOCATION:
sec. 21 T-50 S R-19 E
W
miles 2.7 of Hathorn
(distance) (direction) (nearest town)

WELL PURPOSE:
(home, irrigation, municipal, industrial)

WELL COMPLETION DATA:
(1) diameter (inches) 2"
(2) total depth (feet) 62
(3) static water level (feet) 15 below above top of ground.
(4) casing PVC 52
(material) (depth)
if telescope see back.
(size)
(5) screen 10 52
(length) (depth to top)
2" PVC
(size) (material)
(6) pump 1 12
(HP) (yield gpm)
elect
(type power)
(7) electric log (yes or no)
(organization running log)

(8) how well bottom plugged sand
5h shale

DRILLERS REMARKS: good well


DEPT. OF NATURAL RESOURCES
BUREAU OF LAND & WATER RESOURCES

SEP 27 1983

RECEIVED

If well telescopes please sketch and show depths.

GROUND LEVEL

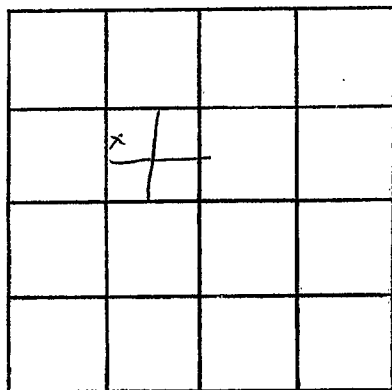

SECTION 21

Please indicate well location X.

ADDITIONAL INFORMATION

If more than one screen, show locations of each on sketch.