

Marion
 B
 2013

MISSISSIPPI DEPARTMENT OF NATURAL RESOURCES
 Bureau of Land and Water Resources
 Southport Mall
 P.O. Box 10631
 Jackson, Mississippi 39209
WATER WELL DRILLERS LOG

10-1 1984 Hollinger Marion
 date well completed firm name county well located

LANDOWNER: Buckley Gro
 Goss, Mrs

description of formations encountered	from	to
sandy, gravel	0	50
clayitic	50	150
pea gravel	150	190

(mailing address)

WELL LOCATION:
 sec. 35 T 05 N R 19 E
 1/2 miles S of Goss
 (distance) (direction) (nearest town)

WELL PURPOSE: Gro.
 (home, irrigation, municipal, industrial)

WELL COMPLETION DATA:

- (1) diameter (inches) 2"
- (2) total depth (feet) 250
- (3) static water level (feet) 30 below above top of ground.
- (4) casing PVC, 190, (material) (depth)
- (size) if telescope see back.
- (5) screen 10, 190 (length) (depth to top)
- (size) (material)
- (6) pump 1/2, 8 (HP) (yield gpm)
- elect. (type power)
- (7) electric log (yes or no)
- (organization running log)
- (8) how well bottom plugged Sand SHARK

DRILLERS REMARKS: Good well


DEPT. OF NATURAL RESOURCES
 BUREAU OF LAND & WATER RESOURCES

NOV 20 1984

RECEIVED

If well telescopes please sketch and show depths.

GROUND LEVEL

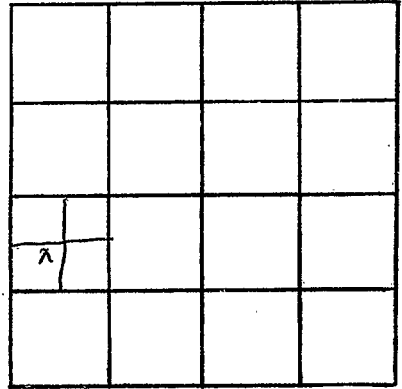

SECTION 35

Please indicate well location X.

ADDITIONAL INFORMATION

If more than one screen,
show locations of each on sketch.