

MISSISSIPPI DEPARTMENT OF NATURAL RESOURCES
Bureau of Land and Water Resources
 Southport Mall
 P.O. Box 10631
 Jackson, Mississippi 39209
WATER WELL DRILLERS LOG

B 2014
MARION
4-2-85

4-2 1985 HOLLINGS MARION
 date well completed firm name county well located

LANDOWNER: Ed Horton
RT 4
Goss, MOSS
 (mailing address)

description of formations encountered	from	to
<u>sand, clay</u>	<u>0</u>	<u>30</u>
<u>chalk</u>	<u>80</u>	
<u>pen & gravel</u>	<u>80</u>	<u>90</u>

WELL LOCATION:
 sec. 21 T. 5 (N) S R. 19 E W
1 miles S of Hathorn
 (distance) (direction) (nearest town)

WELL PURPOSE:
 (home, irrigation, municipal, industrial)

WELL COMPLETION DATA: "

(1) diameter (inches) 4

(2) total depth (feet) 90

(3) static water level (feet) 8 below above top of ground.

(4) casing PVC 80
 (material) (depth)

10 if telescope see back.
 (size)

(5) screen 10 80
 (length) (depth to top)

1 (size) 25 (material)
 (HP) (yield gpm)

elect
 (type power)

(7) electric log _____
 (yes or no)

_____ (organization running log)

(8) how well bottom plugged sand
SHARIC


DRILLERS REMARKS: good well

RECEIVED
 APR 1 1985

Department of Natural Resources
 Bureau of Land & Water Resources

If well telescopes please sketch and show depths.

GROUND LEVEL

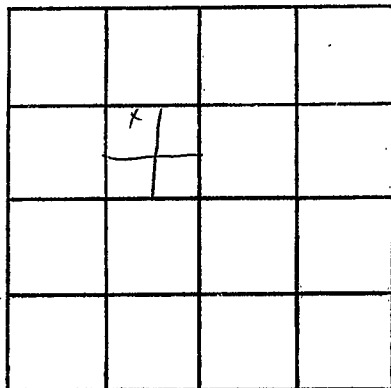

SECTION 21

Please indicate well location X.

ADDITIONAL INFORMATION

If more than one screen,
show locations of each on sketch.