

MISSISSIPPI DEPARTMENT OF NATURAL RESOURCES

Bureau of Land and Water Resources

Southport Mall

P.O. Box 10631

Jackson, Mississippi 39209

WATER WELL DRILLERS LOG

Marion  
B 2016

1-27  
date well completed

1986  
firm name

Marion  
county well located

LANDOWNER:	description of formations encountered	from	to
<u>Tommy Wallace</u>	<u>Red clay</u>	<u>0</u>	<u>20</u>
<u>P.R. - Columbia, ms.</u>	<u>Fine sand &amp; clay streaks</u>	<u>20</u>	<u>100</u>
<u>(mailing address)</u>	<u>Coarse sand &amp; gravel</u>	<u>100</u>	<u>115</u>
<b>WELL LOCATION:</b>			
sec. <u>19</u> T. <u>5</u> N. R. <u>19</u> E.			
<u>5</u> miles <u>NW</u> of <u>Gass</u>			
<u>(distance)</u> <u>(direction)</u> <u>(nearest town)</u>			
<b>WELL PURPOSE:</b> <u>Home</u>			
<u>(home, irrigation, municipal, industrial)</u>			
<b>WELL COMPLETION DATA:</b>			
(1) diameter (inches) <u>4</u>			
(2) total depth (feet) <u>115</u>			
(3) static water level (feet) <u>15</u> below top of ground.			
(4) casing <u>MVC</u> , <u>105</u>			
<u>(material)</u> <u>(depth)</u>			
<u>4</u> if telescope see back.			
<u>(size)</u>			
(5) screen <u>10</u> , <u>105</u>			
<u>(length)</u> <u>(depth to top)</u>			
<u>4</u> , <u>MVC</u>			
<u>(size)</u> <u>(material)</u>			
(6) pump <u>1</u> , <u>25</u>			
<u>(HP)</u> <u>(yield gpm)</u>			
<u>ela</u>			
<u>(type power)</u>			
(7) electric log <u>no</u>			
<u>(yes or no)</u>			
<u>(organization running log)</u>			
(8) how well bottom plugged <u>Shallow</u>			

RECEIVED


JAN 30 1986

DRILLERS REMARKS:

Department of Natural Resources  
Bureau of Land & Water Resources

If well telescopes please sketch and show depths.

GROUND LEVEL

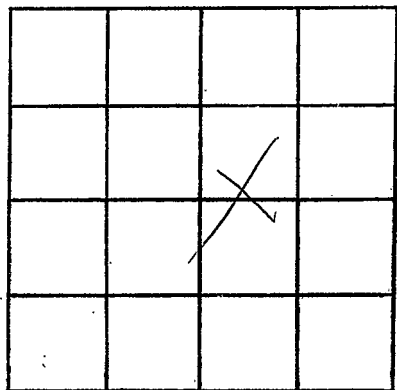

SECTION 19

Please indicate well location X.

ADDITIONAL INFORMATION

If more than one screen,  
show locations of each on sketch.