

MISSISSIPPI DEPARTMENT OF ENVIRONMENTAL QUALITY

Office of Land and Water Resources

P. O. Box 10631

Jackson, MS 39289-0631

WATER WELL DRILLERS LOG

COUNTY WELL LOCATED <i>Marion</i>	
WELL NUMBER <i>3</i>	CODED <i>2019</i>
DATE WELL COMPLETED <i>12-10-92</i>	

PERMIT NUMBER <i>0-402</i>
NAME OF DRILLING FIRM <i>Tom Griffith</i>
<i>Water Well Inc.</i>

NAME & MAILING ADDRESS OF LANDOWNER <i>Wallace Construction</i>		
<i>River Rd</i>		
<i>Columbia Miss 39429</i>		
WELL LOCATION: SEC	TOWNSHIP	RANGE
<i>20</i>	<i>5</i>	<i>19</i>
	<i>N</i>	<i>E</i>
	<i>S</i>	<i>W</i>
DISTANCE	DIRECTION	NEAREST TOWN
<i>5</i> Miles	<i>N. W.</i> of	<i>Yoss</i>
OTHER LANDMARK		
WELL PURPOSE: Home, Irrigation, Municipal, Industrial, Fish Pond, etc. <i>Home</i>		

PUMP DATA		
PUMP TYPE (Circle One): Submersible, Turbine, <input checked="" type="radio"/> Jet, Flowing Well, Other (Describe) _____		
POWER TYPE (Circle One): <input checked="" type="radio"/> Electric, Tractor, Diesel, Gasoline, Butane, Other (Describe) _____ H/P <i>1/2</i>		
Pump Capacity (GPM) <i>10</i>	No. of Stages	Setting Depth <i>30</i> FT.
PUMP TEST		
Well yielded <i>10</i> GPM with a drawdown of _____ ft. after _____ hours of pumping		

WELL DATA		
Well Depth <i>35 FT</i>	Casing Diameter (In.) <i>4 in</i>	Casing Length (Ft.) <i>15</i>
Type of Casing <i>PVC</i>	Hole Depth <i>35 FT</i>	Depth to Static Water Level <i>12</i>

LOG DATA	
TYPE OF LOG RUN (Circle One): Electric, Gamma Ray, Density, Sonic, Neutron, Other (Describe) _____ <input checked="" type="radio"/> No Log Run	
Name of Organization Running Log	

TYPE OF COMPLETION: (Circle One or More):
 Gravel Packed, Underreamed, Telescoped,
 Natural Development, Open Hole, Other

WELL GROUTED TO A DEPTH OF *15* FEET
 Type Grout (circle one) Cement, Bentonite, or Mix

GEOLOGIC DATA (Office Use Only)			
Surface Elev.	Geologic Unit	Unit Thickness	Depth to Top
Subs. SWL	Date	Analysis	Aquifer Test

SCREEN DATA		
Diameter - Inches <i>4 in</i>	Length - Feet <i>20</i>	Slot Size - Inches <i>.010</i>
Screen Type <i>PVC SLOT</i>	Depth to Bottom - Feet <i>12</i>	


Driller's Remarks

DESCRIPTION OF FORMATIONS ENCOUNTERED	FROM	TO
<i>Sand</i>	<i>0</i>	<i>20</i>
<i>Red Gravel</i>	<i>20</i>	<i>35</i>

FORMATIONS LOGGED FROM TO	
RECEIVED	
SEP 17 1993	
Dept. of Environmental Quality Office of Land & Water Resources	
IF MORE SPACE IS NEEDED, USE BACK	

If well telescopes please sketch and show depths.

GROUND LEVEL

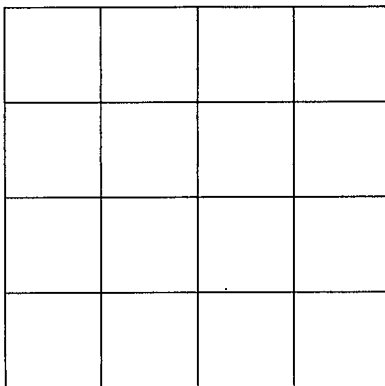

SECTION _____

Please indicate well location X.

ADDITIONAL INFORMATION

If more than one screen,
show location of each on sketch.