

MARION
C1
2-13-69
USGS

MISSISSIPPI
BOARD OF WATER COMMISSIONERS CODED
416 North State Street
Jackson, Mississippi 39201

CODED
CODED
CODED

WATER WELL DRILLERS LOG

Feb 13 19 69 Eriver Drilling Serv. MARION
date well completed firm name county well located

LANDOWNER: Bunker Hill
Water Ass'n.
Columbia Miss
(mailing address)

description of formations encountered	from	to
<u>Top Soil</u>	<u>0</u>	<u>2</u>
<u>Clay</u>	<u>2</u>	<u>75</u>
<u>Sand & Gravel</u>	<u>75</u>	<u>230</u>
<u>Clay</u>	<u>230</u>	<u>363</u>
<u>Coarse Sand</u>	<u>363</u>	<u>560</u>
<u>Blue Clay</u>	<u>560</u>	<u>1020</u>

WELL LOCATION:
sec 4 T 5 N R 18 E
S W
14 miles N of Columbia
(distance) (direction) (nearest town)

WELL PURPOSE: Municipal
(home, irrigation, municipal, industrial)

CODED

- WELL COMPLETION DATA:
- diameter (inches) 6"
 - total depth (feet) 540'
 - static water level (feet) 180' below above top of ground.
 - casing steel, 490',
(material) (depth)
6" if telescope see back.
(size)
 - screen 40, 500'
(length) (depth to top)
4", stainless
(size) (material)
 - pump 15 150
(HP) (yield gpm)
Elec
(type power)
 - electric log yes
(yes/or no)
USFS
(organization running log)
 - how well bottom plugged Back
WASH Valve

CODED

FEB 17 1969


MISS. BD. OF
WATER COMM.

DRILLERS REMARKS:

4

If well telescopes please sketch and show depths.

GROUND LEVEL

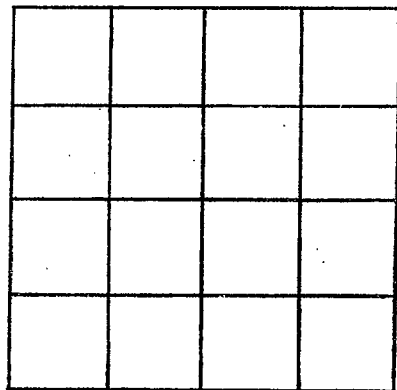

SECTION _____

Please indicate well location X.

ADDITIONAL INFORMATION

If more than one screen, show locations of each on sketch.