

MARION
C2
5-72

MISSISSIPPI
BOARD OF WATER COMMISSIONERS
416 North State Street
Jackson, Mississippi 39201

CODED

WATER WELL DRILLERS LOG

May 1972 E.B. Sheppard Marion
date well completed firm name county well located

LANDOWNER:

Jimmy Shaw
Columbia, Miss
(mailing address)

description of formations encountered

description of formations encountered	from	to
RED SANDY CLAY GRAVEL	0	40
BLUISH + GRAYISH CLAY	40	75
PEA GRAVEL + COARSE SAND	75	99

WELL LOCATION:

sec 21 T 5 N R 18 E
8 miles W of Columbia
(distance) (direction) (nearest town)

WELL PURPOSE:

(home) irrigation, municipal, industrial

WELL COMPLETION DATA:

- (1) diameter (inches) 4"
- (2) total depth (feet) 99'
- (3) static water level (feet) 60' ^{below} top of ground
- (4) casing (material) pl. (depth) 50'
4" (size) if telescope see back.
- (5) screen (length) 10' (depth to top) 4" (size) pl. (material)
- (6) pump 3/4 (HP) 20 (yield gpm)
E (type power)
- (7) electric log (yes or no)
- (organization running log)
- (8) how well bottom plugged BWU

CODED


MAY 26 1972

DRILLERS REMARKS:

MISS. DD
WATER COM
SUFFIX

If well telescopes please sketch and show depths.

GROUND LEVEL

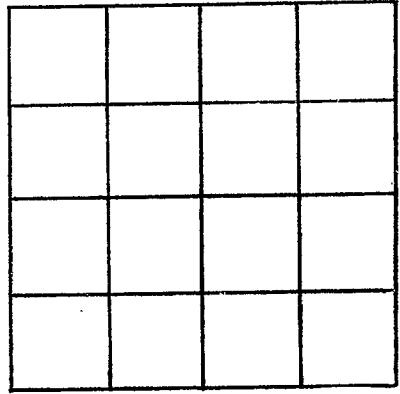

SECTION _____

Please indicate well location X.

ADDITIONAL INFORMATION

If more than one screen, show locations of each on sketch.