

MARION MISSISSIPPI BOARD OF WATER COMMISSIONERS

C3
1-4-63

Second
WATER WELL DRILLERS LOG, E. B. Sherrard Drilling & Water Well Ser.
P. O. Box 467, Columbia, Miss.

Date: 1-4, 1963, Driller: E. B. SHEPPARD County MARION
(Name)

(1) Owner of Land: Mr M. H. Hitt
(Name)
Bunker Hill
(Address)

(2) Location: 1/4, 1/4, Sec. 26 S-18, T R
12 miles NE, of COLUMBIA
(distance) (direction) (Nearest Town)

(3) Topography: (Hilly) (Flat) (Level)

(4) Purpose of Well: (Domestic Irrigation)
 (Municipal, Industrial, Other)

Description & Color of Materials Sand, Clay, Red Clay, Shell, etc.	Thick- ness Feet	Depth Feet
<u>RED SANDY</u>		<u>20</u>
<u>CLAY</u>		<u>40</u>
		<u>60</u>
		<u>80</u>
		<u>100</u>
<u>GRAY CLAY</u>		<u>120</u>
		<u>140</u>
<u>SAND & GRAVEL</u>		<u>160</u>
		<u>180</u>

Information upon completion of well:

(1) Diameter 2 inches.


(2) Total Depth 175 feet.

(3) Water Level _____ feet below top of ground.

(4) Cased to _____, Size _____.

(5) Screen: Size 2, Length 5'.

(6) Were any formations sealed against pollution?
_____ yes, _____ no.

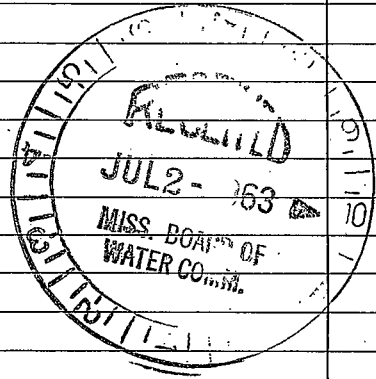

If YES depth of formation _____

Why _____

Drillers Remarks: _____

(Use Back Side)

Well No.

