


C4
11-2-62

CODED

WATER WELL DRILLERS LOG

Date: 11-2, 1962, Driller: E.B. SHERRARD County MARION
(Name)

(1) Owner of Land:	Description & Color of Materials Sand, Clay, Red Clay, Shell, etc.	Thick- ness Feet	Depth Feet
Name: <u>JERRY HATTON</u>	<u>RED CLAY</u>		<u>10'</u>
Address: <u>BUNKER HILL, MISS</u>	" "		<u>20'</u>
Location: <u>3 5-18</u>	" "		<u>30'</u>
Topography: <u>16</u> miles <u>N-E.</u> of <u>COLUMBIA</u>	" "		<u>40'</u>
Purpose of Well: <u>DOMESTIC</u>	<u>SAND STREAKS</u>		<u>50'</u>
Topography: <input checked="" type="checkbox"/> (Hilly) <input type="checkbox"/> (Flat) <input type="checkbox"/> (Level)	<u>GRAY CLAY</u>		<u>60'</u>
Purpose of Well: <u>DOMESTIC</u> (Domestic Irrigation, Municipal, Industrial, Other)	<u>PEA GRAVEL</u>		<u>70'</u>
Information upon completion of well:	<u>COBED</u> " "		<u>80'</u>
(1) Diameter <u>2"</u> inches.			<u>90'</u>
(2) Total Depth <u>100'</u> feet.			<u>100'</u>
(3) Water Level <u>74'</u> feet below top of ground.			
(4) Cased to <u>100'</u> , Size <u>2"</u>			
(5) Screen: Size <u>2"</u> , Length <u>5'</u>			
(6) Were any formations sealed against pollution? _____ yes, <input checked="" type="checkbox"/> no.			
If YES depth of formation _____			
Why _____			
Drillers Remarks: _____			

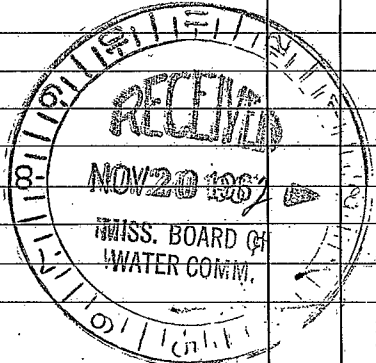

(Use Back Side)

[The page contains extremely faint and illegible text, likely bleed-through from the reverse side of the document. The text is scattered across the page and does not form any recognizable words or sentences.]