

MISSISSIPPI
BOARD OF WATER COMMISSIONERS
416 North State Street
Jackson, Mississippi 39201

CODED

WATER WELL DRILLERS LOG

Marion

C8

1-13-70

1/13 1970 Vern Shivers Marion
date well completed firm name county well located

LANDOWNER:

Berkett Hallock
Route 1 Columbia, Miss.
(mailing address)

description of formations
encountered

from to

Top soil 0-1
Red Clay 1-8
red sand 8-20
fine white sand 20-31
Coarse water sand 31-45

WELL LOCATION:

sec. 22 T5 N R 18 E
S W
(distance) miles (direction) of Columbia (nearest town)

WELL PURPOSE: Home Use
(home, irrigation, municipal, industrial)

WELL COMPLETION DATA:

- (1) diameter (inches) 2"
- (2) total depth (feet) 45'
- (3) static water level (feet) 32 below top of ground.
- (4) casing Plastic 41 (material) (depth)
- (size) if telescope see back.
- (5) screen 4 29 (length) (depth to top)
2" S.S. strainer (size) (material)
- (6) pump 1/2 H.P. (HP) (yield gpm)
McDonald jet pump (type power)
- (7) electric log No (yes or no)
(organization running log)
- (8) how well bottom plugged

CODED


MAR 18 1970

MISS. BD. OF
WATER COMM.

DRILLERS REMARKS:

If well telescopes please sketch and show depths.

GROUND LEVEL

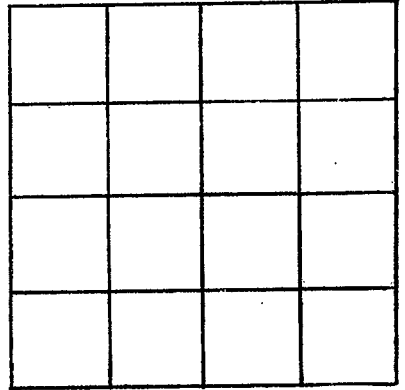

SECTION _____

Please indicate well location X.

ADDITIONAL INFORMATION

If more than one screen, show locations of each on sketch.