

MISSISSIPPI
BOARD OF WATER COMMISSIONERS
416 North State Street
Jackson, Mississippi 39201

CODED

WATER WELL DRILLERS LOG

Marion
C 10
2-70

FEB. 1970 E.B. SHEPARD MARION
date well completed firm name county well located

LANDOWNER:	description of formations encountered	from	to
THOMAS ALLEN			
Rt. 3 - Columbia, Miss. (mailing address)	RED FINE SANDY CLAY	30	60'
WELL LOCATION: sec. 12 T. 5 ^N R. 18 ^W	SANDY RED CLAY	60	90'
11 miles NNE of Columbia (distance) (direction) (nearest town)	BLUE CLAY	90	180'
WELL PURPOSE: (home, irrigation, municipal, industrial)	COARSE SANDY GRAVEL	180	196'
GRAVEL			
WELL COMPLETION DATA:			
(1) diameter (inches) 2"			
(2) total depth (feet) 196'			
(3) static water level (feet) 130' below top of ground.			
(4) casing PL (material), 196' (depth)			
2" (size) if telescope see back.			
(5) screen 3' (length), (depth to top)			
2 1/2" (size), S.S. (material)			
(6) pump 2 (HP), 7 (yield gpm)			
E (type power)			
(7) electric log (yes or no)			
(organization running log)			
(8) how well bottom plugged BWV			

CODED


MAR 17 1970

DRILLERS REMARKS:

MISS. BD. OF
WATER COMM.

If well telescopes please sketch and show depths.

GROUND LEVEL

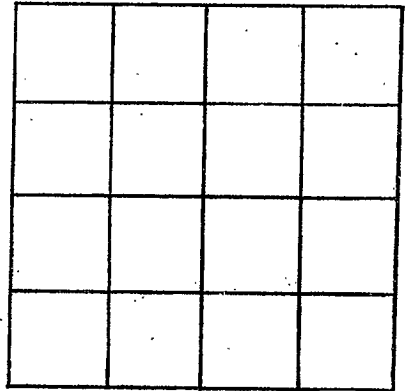

SECTION _____

Please indicate well location X.

ADDITIONAL INFORMATION

If more than one screen,
show locations of each on sketch.