

MISSISSIPPI
 BOARD OF WATER COMMISSIONERS
 416 North State Street
 Jackson, Mississippi 39201

CODED

WATER WELL DRILLERS LOG

MARION
 C 11
 8-70

August 1970 E. B. SHERRARD MARION
 date well completed firm name county well located

| LANDOWNER: | description of formations encountered | from | to |
|---|---------------------------------------|------|----|
| MILTON CARSON COLUMBIA, Miss. (mailing address) | | | |
| WELL LOCATION: sec. 11 T. 5 N S R. 18 E 10 miles NNE of Columbia (distance) (direction) (nearest town) | | | |
| WELL PURPOSE: DAIRY (home, irrigation, municipal, industrial) | | | |
| WELL COMPLETION DATA: | | | |
| (1) diameter (inches) 4" | | | |
| (2) total depth (feet) 160 | | | |
| (3) static water level (feet) 70 below top of ground. | | | |
| (4) casing PL. 150 (material) (depth) 4" (size) if telescope see back. | | | |
| (5) screen 10' (length) (depth to top) 4" (size) PLASTIC (material) | | | |
| (6) pump 3/4 SUB. 25 (HP) (yield gpm) E (type power) | | | |
| (7) electric log (yes or no) | | | |
| (organization running log) | | | |
| (8) how well bottom plugged BNY | | | |

CONTINUED


OCT 19 1970

MISS. RD. 05
 WATER COMM.

DRILLERS REMARKS:

If well telescopes please sketch and show depths.

GROUND LEVEL

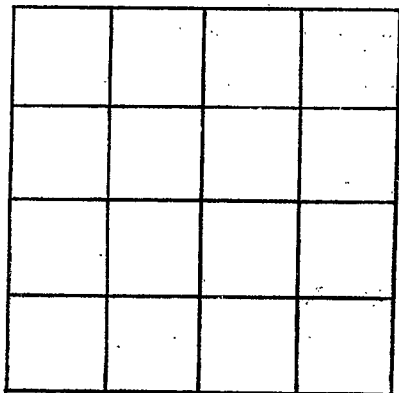

SECTION _____

Please indicate well location X.

ADDITIONAL INFORMATION

Lined area for additional information.

If more than one screen, show locations of each on sketch.