

MARION
C 12
11-70

MISSISSIPPI
BOARD OF WATER COMMISSIONERS
416 North State Street
Jackson, Mississippi 39201

CODED

WATER WELL DRILLERS LOG

Nov. 1970 E.B. Sheward Marion
date well completed firm name county well located

LANDOWNER:
Bobby Barefoot
Rt. 3 - Columbia, Miss.
(mailing address)

description of formations encountered	from	to
RED SANDY CLAY	0	22'
RED SAND	4	
GRAVEL	22'	60'

WELL LOCATION:
sec 20 T. 5 N R. 18 E
8 miles N of Columbia
(distance) (direction) (nearest town)

WELL PURPOSE:
(home, irrigation, municipal, industrial)

- WELL COMPLETION DATA:
- (1) diameter (inches) 2"
 - (2) total depth (feet) 60
 - (3) static water level (feet) 38 ^{below} top of ground
 - (4) casing PL. 55' (material), (depth)
2" (size) if telescope see back.
 - (5) screen 3' (length), (depth to top)
2" (size), PL. (material)
 - (6) pump 1-HP. 9 (HP) (yield gpm)
E (type power)
 - (7) electric log (yes or no)
 - (organization running log)
 - (8) how well bottom plugged BWV

CODED


FEB 1 1971

MISS. BD. OF
WATER COMM.

DRILLERS REMARKS:

If well telescopes please sketch and show depths.

GROUND LEVEL

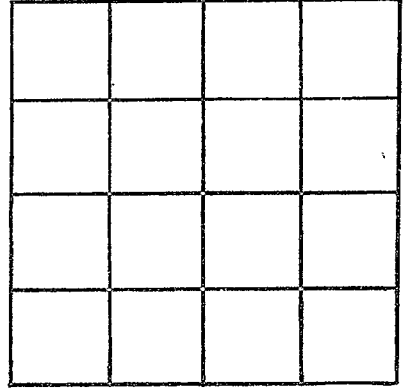

SECTION _____

Please indicate well location X.

ADDITIONAL INFORMATION

If more than one screen, show locations of each on sketch.