

MISSISSIPPI
BOARD OF WATER COMMISSIONERS
416 North State Street
Jackson, Mississippi 39201

WATER WELL DRILLERS LOG

CODED

Marion
C-13
7-71

July 1971
date well completed

E. B. SHERRARD
firm name

Mississippi
county well located

LANDOWNER:
DEWITT ROBBINS
Rt. 3 Columbia
(mailing address)

description of formations encountered	from	to
GRAVEL CLAY		
+ SAND	0	120'
COARSE GRAVE SAND + PEA GR.	120'	142'

WELL LOCATION:
sec. 1 T 5 N R. 18 E
S 27
11 miles NNE of Columbia
(distance) (direction) (nearest town)

WELL PURPOSE:
 (home) Irrigation, municipal, industrial

WELL COMPLETION DATA:

(1) diameter (inches) 3"

(2) total depth (feet) 142

(3) static water level (feet) 110 below above top of ground.

(4) casing PL. 136
(material) (depth)
3" if telescope see back.
(size)

(5) screen 6' PL.
(length) (depth to top)
3" PL.
(size) (material)

(6) pump 1/2 9
(HP) (yield gpm)
E
(type power)

(7) electric log (yes or no)
(organization running log)

(8) how well bottom plugged BWV

CODED


SEP 15 1971

DRILLERS REMARKS:

MISS. BD. OF
WATER COMM.

If well telescopes please sketch and show depths.

GROUND LEVEL

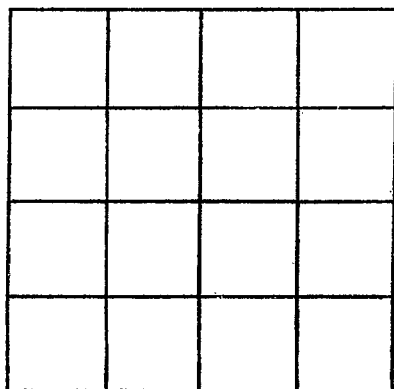

SECTION _____

Please indicate well location X.

ADDITIONAL INFORMATION

If more than one screen,
show locations of each on sketch.