

MARION  
C14

3-73

MISSISSIPPI  
BOARD OF WATER COMMISSIONERS  
416 North State Street  
Jackson, Mississippi 39201

**CODED**

WATER WELL DRILLERS LOG

March 73  
date well completed

E.B. Sheppard  
firm name

Marion  
county/well located

LANDOWNER:

Clayton Robbins  
Columbia  
(mailing address)

description of formations  
encountered

from

to

B.F.D. SAND  
CLAY 110  
GRAVEL & CLAY 110 160  
D.F.A. GRAVEL SAND 160 174

WELL LOCATION:

sec. 1 T 5 N R 18 E  
12 miles NE of Columbia  
(distance) (direction) (nearest town)

WELL PURPOSE:

(home, irrigation, municipal, industrial)

WELL COMPLETION DATA:

- (1) diameter (inches) 3"
- (2) total depth (feet) 174'
- (3) static water level (feet) 100' below above top of ground.
- (4) casing 3" 168' (material) (depth)  
3" if telescope see back. (size)
- (5) screen 6' (length) (depth to top)  
3" (size) (material)
- (6) pump 1/2 (HP) 8 (yield gpm)  
E (type power)
- (7) electric log (yes or no)

**CODED**


(organization running log)

(8) how well bottom plugged B.W.V.

DRILLERS REMARKS:

If well telescopes please sketch and show depths.

GROUND LEVEL

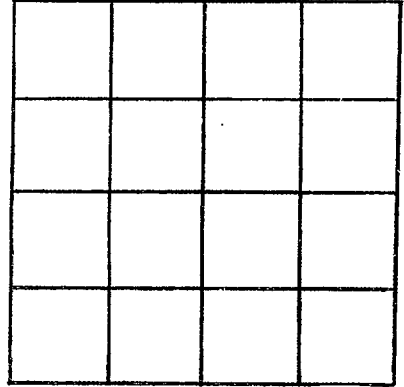

SECTION \_\_\_\_\_

Please indicate well location X.

ADDITIONAL INFORMATION

If more than one screen,  
show locations of each on sketch.