

MARION
C 15
1-73

MISSISSIPPI
BOARD OF WATER COMMISSIONERS
416 North State Street
Jackson, Mississippi 39201

CODED

WATER WELL DRILLERS LOG

Jan 73 date well completed E.B. Sheward firm name Marion county well located

LANDOWNER:
Thomas Outrey
Rt. 3 - Columbia, Miss.
(mailing address)

description of formations encountered	from	to
SANDY BED		
CLAY	0	90
SAND	90	150
REA. EA. & SAND	150	180

WELL LOCATION:
sec. 13 T. 5 N R. 18 E
S W
10 miles NNE of Columbia
(distance) (direction) (nearest town)

WELL PURPOSE:
(home, irrigation, municipal, industrial)


- WELL COMPLETION DATA:
- (1) diameter (inches) 4"
 - (2) total depth (feet) 180'
 - (3) static water level (feet) 90' ^{below} top of ground
 - (4) casing pl. (material), 170' (depth)
4" (size) if telescope see back.
 - (5) screen 10' (length), (depth to top)
4" (size), pl. (material)
 - (6) pump 3/4 (HP), 15 (yield gpm)
E (type power)
 - (7) electric log (yes or no) no
(organization running log)
 - (8) how well bottom plugged BWV

CODED

DRILLERS REMARKS:

If well telescopes please sketch and show depths.

GROUND LEVEL

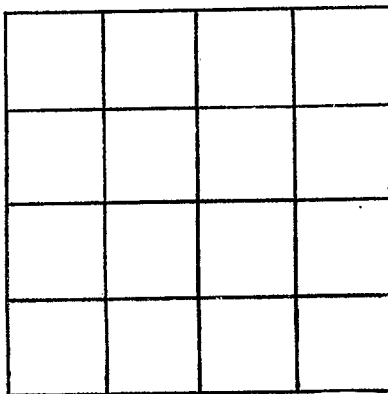

SECTION _____

Please indicate well location X.

ADDITIONAL INFORMATION

If more than one screen,
show locations of each on sketch.