

MARION
C 16
8/73

MISSISSIPPI
BOARD OF WATER COMMISSIONERS
416 North State Street
Jackson, Mississippi 39201

CODED

WATER WELL DRILLERS LOG

Aug. 1973 E.B. Sherrard Marion
date well completed firm name county well located

LANDOWNER:
Billy Moore
P.O. 3 - Columbia
(mailing address)

description of formations encountered	from	to
SANDY CLAY	0	30'
FINE SANDY GR. MIXED	30	60'
COARSE DETA GR.	60	82'

WELL LOCATION:
sec 24 T 5 N R 18 E
8 miles NW of Columbia
(distance) (direction) (nearest town)

WELL PURPOSE:
(home, irrigation, municipal, industrial)

- WELL COMPLETION DATA:
- (1) diameter (inches) 4"
 - (2) total depth (feet) 82'
 - (3) static water level (feet) 35' below top of ground.
 - (4) casing (material) pl. (depth) 72'
 - 4" (size) if telescope see back.
 - (5) screen 10' (length) (depth to top)
 - 4" (size) pl. (material)
 - (6) pump 1-SUB. (HP) 20 (yield gpm)
 - E. (type power)
 - (7) electric log (yes or no) (no)
 - (organization running log)
 - (8) how well bottom plugged B/W

CODED


DRILLERS REMARKS:

FEB 8 1974

MISS. BD OF WATER COMMISSIONERS

If well telescopes please sketch and show depths.

GROUND LEVEL

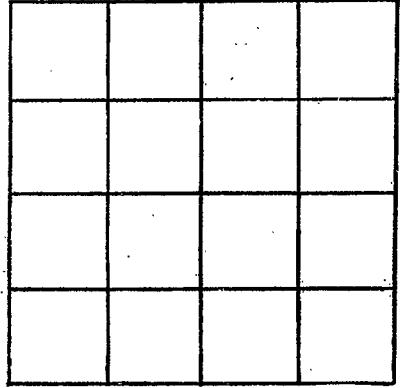

SECTION _____

Please indicate well location X.

ADDITIONAL INFORMATION

If more than one screen, show locations of each on sketch.