

Marion
C 19
9/74

MISSISSIPPI
BOARD OF WATER COMMISSIONERS
416 North State Street
Jackson, Mississippi 39201

CODED

WATER WELL DRILLERS LOG

Sept. 19 74 ¹³⁶ E. B. Sherrard Marion
date well completed firm name county well located

LANDOWNER:

Jim Aaener
Rt. 3 Columbia, Ms
(mailing address)

description of formations encountered

from to

GRAY CLAY	0	140
GRAY SANDY		
CTH. FAKS	140	185
COARSE FEA GR.		
WHITE SAND	185	210

WELL LOCATION:

sec. 33 T 5 N R 18 E
S W
6 miles N of Columbia
(distance) (direction) (nearest town)


WELL PURPOSE:

(home) irrigation, municipal, industrial

WELL COMPLETION DATA:

- (1) diameter (inches) 2"
- (2) total depth (feet) 210'
- (3) static water level (feet) 140' ^{below} above top of ground.
- (4) casing cpd. (material) 205 (depth)
- 2" If telescope see back. (size)
- (5) screen 5' (length) (depth to top)
- 2" (size) pl. (material)
- (6) pump 2 (HP) 6 (yield gpm)
- e (type power)
- (7) electric log (yes or no) (no)
- (organization running log)
- (8) how well bottom plugged BWV


DRILLERS REMARKS:

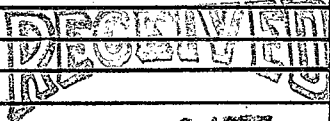

MAY - 8 1975

If well telescopes please sketch and show depths.

GROUND LEVEL

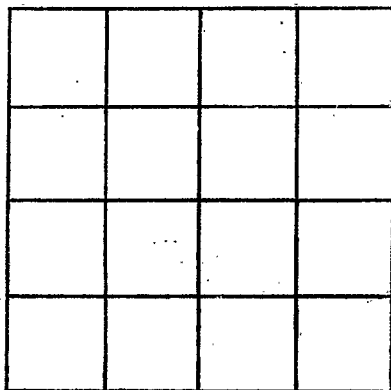

SECTION _____

Please indicate well location X.

ADDITIONAL INFORMATION

If more than one screen, show locations of each on sketch.