

Manion
C. 20
6-6-75

MISSISSIPPI
 BOARD OF WATER COMMISSIONERS
 416 North State Street
 Jackson, Mississippi 39201

CODED

WATER WELL DRILLERS LOG

6-6 1975 CRINER-GINN Manion
 date well completed firm name county well located

CODED

LANDOWNER:
Casper Coak
Rt. 7 Columbia, Miss
 (mailing address)

description of formations encountered	from	to
<u>Top Soil</u>	<u>0</u>	<u>1</u>
<u>Clay</u>	<u>1</u>	<u>85</u>
<u>Clay + Chalk</u>	<u>85</u>	<u>96</u>
<u>Chalk</u>	<u>96</u>	<u>131</u>
<u>Sand</u>	<u>131</u>	<u>160</u>

WELL LOCATION:
 sec. 22 T 5 N R. 18 130
8 miles N of Columbia
 (distance) (direction) (nearest town)

WELL PURPOSE: Home
 (home, irrigation, municipal, industrial)


- WELL COMPLETION DATA:
- (1) diameter (inches) 2"
 - (2) total depth (feet) 160
 - (3) static water level (feet) 120 below above top of ground.
 - (4) casing PVC, 150,
 (material) (depth)
2" if telescope see back.
 (size)
 - (5) screen 10', 150
 (length) (depth to top)
2", PVC
 (size) (material)
 - (6) pump 1 1/2,
 (HP) (yield gpm)
elec
 (type power)
 - (7) electric log NO
 (yes or no)
- (organization running log)
- (8) how well bottom plugged
B.W. VALVE

DRILLERS REMARKS:

RECEIVED
AUG 12 1975
 MISS. BD. OF WATER COMMISSIONERS

If well telescopes please
sketch and show depths.

GROUND LEVEL

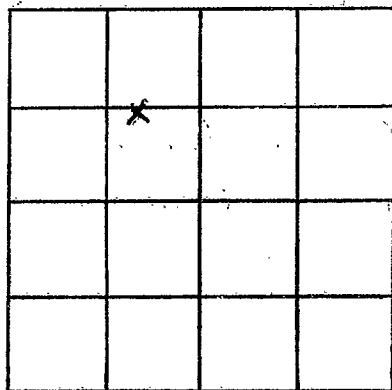

SECTION _____

Please indicate well location X.

ADDITIONAL INFORMATION

If more than one screen,
show locations of each on sketch.