

MISSISSIPPI DEPARTMENT OF NATURAL RESOURCES

Bureau of Land and Water Resources

Southport Mall

P.O. Box 10631

Jackson, Mississippi 39209

WATER WELL DRILLERS LOG

Marion  
C 22  
11-12-86

copy  
 Coded

11-12 1986 Hollinger Marion  
 date well completed firm name county well located

LANDOWNER: John Groth  
Rt 3 Box 112 B  
Columbia, MS  
 (mailing address)

description of formations encountered	from to	
Sand	0	90
Chalk	90	140
Sand	140	170
Chalk	170	390
Coarse sand	390	450

WELL LOCATION:  
 sec 36 T 5 (N) R 18 E  
12 miles NE of Columbia  
 (distance) (direction) (nearest town)

WELL PURPOSE:  
 (home, irrigation, municipal, industrial)

WELL COMPLETION DATA:

- (1) diameter (inches) 4"
- (2) total depth (feet) 450
- (3) static water level (feet) 210 below above top of ground.
- (4) casing PVC 430  
 (material) (depth)  
 (size) If telescope see back.
- (5) screen 10 430  
 (length) (depth to top)  
4 PVC  
 (size) (material)
- (6) pump 5 100  
 (HP) (yield gpm)  
elect  
 (type power)
- (7) electric log (yes or no)

(organization running log)

(8) how well bottom plugged Sand  
Shale

DRILLERS REMARKS: Very Good  
well


RECEIVED

DEC 11 1987

Department of Natural Resources  
 Bureau of Land & Water Resources

If well telescopes please sketch and show depths.

GROUND LEVEL

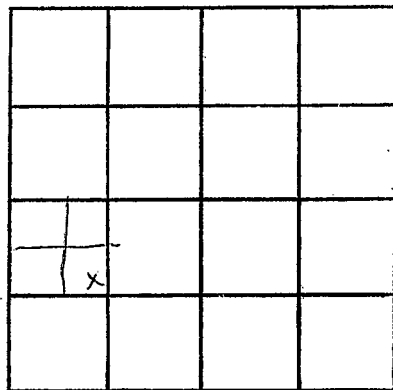

SECTION 36

Please indicate well location X.

ADDITIONAL INFORMATION

If more than one screen,  
show locations of each on sketch.