

MISSISSIPPI DEPARTMENT OF NATURAL RESOURCES

Bureau of Land and Water Resources

Southport Mall

P.O. Box 10631

Jackson, Mississippi 39209

WATER WELL DRILLERS LOG

Marion
C 23
5-19-88

Cochran

5-19 1988
 date well completed

Hollinger
 firm name

Marion
 county well located

LANDOWNER: LONNIE PRING

description of formations encountered

from

to

Bunker Hill, GMS
 (mailing address)

Clay
sand gravel

0 20
20 150

WELL LOCATION:


sec. 2 T 5 N R 18 E
5 miles S of Brassfield
 (distance) (direction) (nearest town)

WELL PURPOSE:

(home, irrigation, municipal, industrial)

WELL COMPLETION DATA:

- (1) diameter (inches) 4
- (2) total depth (feet) 150
- (3) static water level (feet) 80 ^{below} _{above} top of ground.
- (4) casing pvc 150
 (material) (depth)
 (size) if telescope see back.
- (5) screen 10 140
 (length) (depth to top)
4 pvc
 (size) (material)
- (6) pump 5 100
 (HP) (yield gpm)
elect
 (type power)
- (7) electric log _____
 (organization running log)

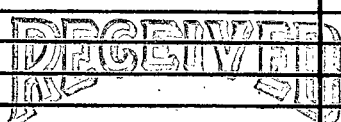


Department of Natural Resources
 Bureau of Land & Water Resources

(8) how well bottom plugged SAND
SHALE

DRILLERS REMARKS: Very Good
well

If well telescopes please sketch and show depths.

GROUND LEVEL

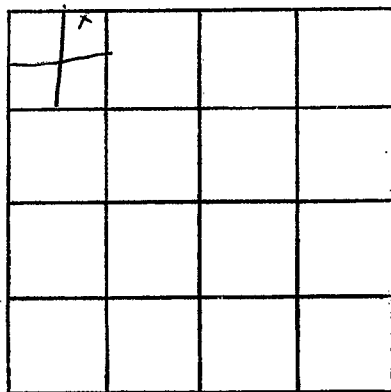

SECTION _____

Please indicate well location X.

ADDITIONAL INFORMATION

If more than one screen,
show locations of each on sketch.