

### State Well Report

#### Part 1

Mississippi Department of Environmental Quality  
 Office of Land and Water Resources  
 P.O. Box 10631  
 Jackson, MS 39289-0631  
 (601)961-5210  
 (601)354-6938 (fax)

County: MARION  
 Permit #: \_\_\_\_\_  
 Driller: Travis Boone  
 Date drilling completed: 5-1-09

For Office Use Only:  
 Aquifer: \_\_\_\_\_  
 Well #: C65  
 L.S. Elevation: \_\_\_\_\_  
 E-log #: \_\_\_\_\_

State Law requires that this report be prepared by the driller in detail and filed with the Department within 30 days of completion of drilling of the well.

Well Owner Information	Well Location
Owner Name: <u>Kyle Wilks</u>	Latitude: <u>31° 24' 26"</u> Longitude: <u>91° 46' 12"</u>
Mailing Address: <u>355 Allen Rd</u> <u>Columbia, MS</u> <u>39429</u>	Method of Lat/Long (circle one): <u>Conventional Survey</u> <u>USGS quad, Hand-held GPS, Survey-grade GPS</u>
City: _____ State: _____ Zip Code: _____	<u>S14 W 51N 4 Sec 12 Twn 5N Rng 18W</u>
Telephone No. ( ) _____	Distance: <u>11</u> Miles Direction: <u>N</u> of Nearest Town: <u>Columbia</u>

**Well Data**

Purpose of Well (circle one): Home Industrial Public Supply Irrigation Fish Culture Other: \_\_\_\_\_

Date well drilling started: 4-30-09 Date well drilling completed: 5-1-09

If flowing, method of flow regulation: Valve \_\_\_\_\_ Other (describe): \_\_\_\_\_

Static Water Level: 120 feet above below (circle one) land surface Date measured: 5-1-09

Method of Measurement (circle one) steel tape electric tape air line other: StringLine

Hole depth: 200 Well depth: 200 Well grouted to a depth of 10 feet

Type of grout (circle one): Concrete Bentonite Mix

Casing length: 180 feet Casing diameter: 4 inches Type of casing: SCH 40

Screen length: 20 feet Screen diameter: 4 inches Type of screen: SCH 40

Screen slot size: 8 inches Setting depth: From 180 feet to 200 feet

Type of completion (circle all applicable): Gravel packed Underscreened Telescoped Open hole Natural Development  
 Other (describe): \_\_\_\_\_

Top of lap pipe or reduction in casing: \_\_\_\_\_ feet. If telescoped or more than one screen, describe on back of page

Logs run (circle all applicable): No log run Electric Gamma Ray Density Sonic Neutron Other: \_\_\_\_\_

Name of organization running log(s): \_\_\_\_\_

I certify that the well was drilled, constructed, and completed in accordance with all applicable requirements of the Mississippi Department of Environmental Quality and/or the Mississippi Department of Health regulations and state laws.


Travis Boone 0-514  
 Print Name of Water Well Contractor and License No.

Travis Boone  
 Signature of Water Well Contractor

105

If well encountered please sketch below and show depth.

Ground Level

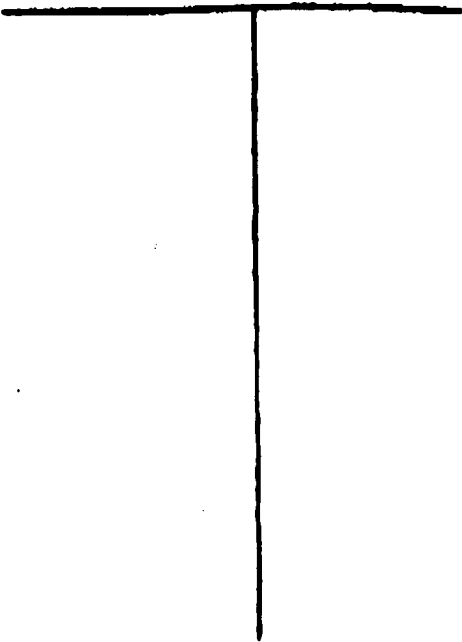

Description of Function Encountered		Feet	In
	CLAY	0	20
	SAND & GRAVEL	20	260

If more than one casing, show location of each on sketch

Sketch the property layout and include the following: 1) the well location; 2) any permanent structures on the property that may aid in locating the well; 3) any roads, power lines, or other items that may aid in locating the property and the well; 4) indicate direction.

Landowner Name: Kyle Wilks

Mavis Borne  
 Signature of Water Well Contractor

# STATE WELL REPORT

## Part 2

**Pump Installer's Completion Report**  
 Mississippi Department of Environmental Quality  
 Office of Land and Water Resources  
 P.O. Box 10091  
 Jackson, MS 39208-0091  
 (601)961-5210  
 (601)954-6738 (fax)

County: Madison  
 Permit #: \_\_\_\_\_  
 Diller: Travis Boone  
 Date completed: 5-1-09

**For Office Use Only**  
 Aquifer: \_\_\_\_\_  
 Well #: 65  
 Remarks: \_\_\_\_\_

This report should be prepared by the pump installer in detail and filed with the Department within 30 days of the installation of pump.

Well Owner Information	Well Location
Owner Name: <u>Kyle Wilks</u>	Latitude: _____ Longitude: _____
Mailing Address: <u>355 Allen Rd</u> <u>Columbia, MS</u>	Method of Locating (circle one): <u>Conventional Survey</u>
City: _____ State: _____ Zip Code: <u>39429</u>	USGS quad, Hand-held GPS, Survey-grade GPS
Telephone No. (_____) _____	_____ W _____ N Sec <u>12</u> Twp <u>5N</u> Rng <u>18W</u>
	Distance Direction Nearest Town
	<u>11 Miles N of Columbia</u>

Pump Type Circle one	Power Type Circle one
Air Lift <input type="checkbox"/> Jet <input checked="" type="checkbox"/> <u>Submersible</u>	Diesel Engine <input type="checkbox"/> Gasoline Engine <input type="checkbox"/> Natural Gas <input type="checkbox"/>
Bucket <input type="checkbox"/> Plunger <input type="checkbox"/> Turbine <input type="checkbox"/>	<u>Electric Motor</u> <input checked="" type="checkbox"/> Hand <input type="checkbox"/> Tractor PTO <input type="checkbox"/>
Centrifugal <input type="checkbox"/> Rotary <input type="checkbox"/> Floating Well <input type="checkbox"/>	Windmill <input type="checkbox"/> Other (specify): _____
Other (specify): _____	Name Power Rating of Motor: <u>1</u>
Date Pump Installed: <u>5-1-09</u>	Setting Depth: <u>160</u> feet
Rated Pump Capacity: <u>12</u> Gallons Per Minute	Number of Stages: _____

Pump Test Data	Method of Measuring Water Level Circle one
Date Well Tested: <u>5-1-09</u>	Air Line <input type="checkbox"/> Electric Measuring Line <input type="checkbox"/> Steel Tape <input type="checkbox"/>
Static Water Level (A): <u>120</u> Feet Below Land Surface	Other (specify): <u>string line</u>
Pumping Water Level (B): _____ Feet Below Land Surface	For flowing well, measured draw in foot: _____ feet
Drawdown (D) - (A): _____ Feet Below Land Surface	Well yielded _____ GPM with a drawdown of _____ feet after _____ hours of pumping
Test Pumping Rate: <u>160E</u> Gallons Per Minute	
Duration of Pump Test (minimum 4 hours): _____ hours	

I HEREBY CERTIFY that the above statements are true to the best of my knowledge.

Travis Boone \_\_\_\_\_  
 Print Name of Pump Installer and Mailing No. (if applicable)

Travis Boone \_\_\_\_\_  
 Signature of Pump Installer