

Marion
C. 2001
7-75

MISSISSIPPI
BOARD OF WATER COMMISSIONERS
416 North State Street
Jackson, Mississippi 39201

WATER WELL DRILLERS LOG

July 1975 E. B. Sherard Marion
date well completed firm name county (well located)


LANDOWNER:	description of formations encountered	from	to
Ray Johnson Columbia, Ms. (mailing address)	BLUE CLAY SAND + GRAVEL	0	40' 70'
WELL LOCATION: sec. 23 T 5 N R 18 E 13V 8 miles NNE of Columbia (distance) (direction) (nearest town)			
WELL PURPOSE: <input checked="" type="checkbox"/> (home) irrigation, municipal, industrial			
WELL COMPLETION DATA:			
(1) diameter (inches) 2"			
(2) total depth (feet) 70'			
(3) static water level (feet) 12' below above top of ground.			
(4) casing pl. 65' (material) (depth)			
2" (size) if telescope see back.			
(5) screen 5' (length) (depth to top)			
2" pl. (size) (material)			
(6) pump 1/3 (HP) 8 (yield gpm)			
E (type power)			
(7) electric log (yes or no) (yes)			
(organization running log)			
(8) how well bottom plugged BWV			
DRILLERS REMARKS:			

RECEIVED
DEC - 5 1975

MISS. BO. OF WATER COMMISSIONERS

If well telescopes please sketch and show depths.

GROUND LEVEL

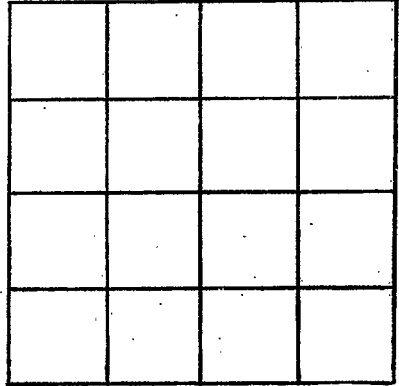

SECTION _____

Please indicate well location X.

ADDITIONAL INFORMATION

If more than one screen, show locations of each on sketch.