

Marion
C 2002
Jan. 1976

MISSISSIPPI
BOARD OF WATER COMMISSIONERS
416 North State Street
Jackson, Mississippi 39201

WATER WELL DRILLERS LOG

JAN. 1976 E.B. SHEPARD MARION
date well completed firm name county well located

LANDOWNER:
G.A. BURKIN
Columbia, Miss.
(mailing address)

description of formations encountered	from	to
RED CLAY	0	40'
GRAY CLAY	40	80'
FINE SAND		
STREAKS CLAY	80	120'
COARSE SAND & GRA G.	120	137'

WELL LOCATION:
sec 15 T 5 N R 18 E
S W
10 miles N of Columbia
(distance) (direction) (nearest town)

WELL PURPOSE:
(home, irrigation, municipal, industrial)

- WELL COMPLETION DATA:
- (1) diameter (inches) ~~7 3/4~~ 2"
 - (2) total depth (feet) 137'
 - (3) static water level (feet) 80' ^{below}/_{above} top of ground.
 - (4) casing cpl. 132'
(material) (depth)
2"
(size) if telescope see back.
 - (5) screen 5'
(length) (depth to top)
2" pl.
(size) (material)
 - (6) pump 1 1/2 7
(HP) (yield gpm)
elec.
(type power)
 - (7) electric log (yes or no) (no)

(organization running log)

(8) how well bottom plugged BLW


DRILLERS REMARKS:

RECEIVED

OCT 18 1976

If well telescopes please sketch and show depths.

GROUND LEVEL

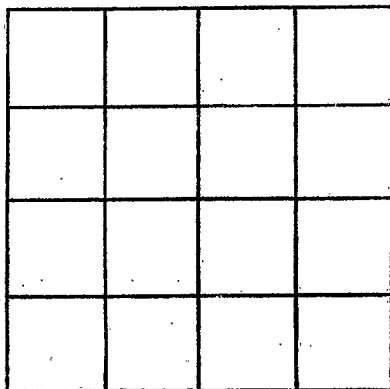

SECTION _____

Please indicate well location X.

ADDITIONAL INFORMATION

If more than one screen, show locations of each on sketch.