

MARION  
G 2003  
1-16-76

MISSISSIPPI  
BOARD OF WATER COMMISSIONERS  
416 North State Street  
13V Jackson, Mississippi 39201

WATER WELL DRILLERS LOG

1-16 1976 Coriner - Binn Marion  
date well completed firm name county well located


LANDOWNER:  
Julian Robertson  
Rt. 4 Columbia, Miss  
(mailing address)

WELL LOCATION:  
sec. 16 T. 5 N R. 18 E  
W  
1 miles W of Corinth  
(distance) (direction) (nearest town)

WELL PURPOSE: Home  
(home, irrigation, municipal, industrial)

WELL COMPLETION DATA:  
(1) diameter (inches) 4"  
(2) total depth (feet) 370  
(3) static water level (feet) 190 below  
top of ground.  
(4) casing PVC, 360,  
(material) (depth)  
4"  
(size) If telescope see back.  
(5) screen 10', 360,  
(length) (depth to top)  
4", PVC  
(size) (material)  
(6) pump 3/4, 12,  
(HP) (yield gpm)  
elec.  
(type power)  
(7) electric log NO  
(yes or no)  
  
(organization running log)  
  
(8) how well bottom plugged  
B.W. Valve

description of formations encountered	from	to
<u>Top soil</u>	<u>0</u>	<u>2</u>
<u>Clay</u>	<u>2</u>	<u>6</u>
<u>Argill</u>	<u>6</u>	<u>29</u>
<u>Sand</u>	<u>29</u>	<u>62</u>
<u>Chalk</u>	<u>62</u>	<u>96</u>
<u>Sand</u>	<u>96</u>	<u>160</u>
<u>Chalk</u>	<u>160</u>	<u>202</u>
<u>Sand</u>	<u>202</u>	<u>321</u>
<u>Gravel</u>	<u>321</u>	<u>341</u>
<u>Sand</u>	<u>341</u>	<u>370</u>

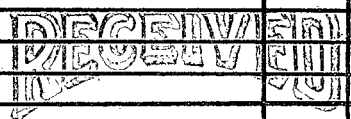


MAR 29 1976

DRILLERS REMARKS:

If well telescopes please  
sketch and show depths.

GROUND LEVEL

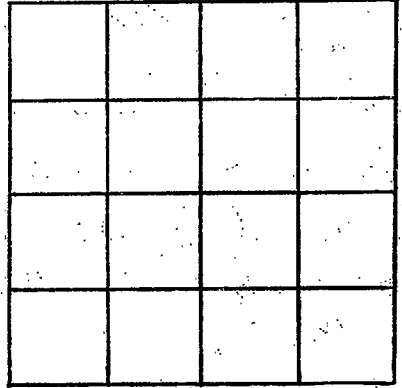

SECTION \_\_\_\_\_

Please indicate well location X.

ADDITIONAL INFORMATION

If more than one screen,  
show locations of each on sketch.