

Marion
C. 2004
11/27/76

MISSISSIPPI
BOARD OF WATER COMMISSIONERS
416 North State Street
13V Jackson, Mississippi 39201

WATER WELL DRILLERS LOG

11-27 1976
date well completed

Hollinger Plumb
firm name

Marion
county well located

LANDOWNER: Terry Lee
Rt. 5
Columbia, Miss. 39429
(mailing address)

description of formations encountered

from to

Red clay
sand gravel
0 20
20 60

WELL LOCATION:

sec. 2 T-5 (N) R-18 E
2+ miles N of Bunker
(distance) (direction) (nearest town)

WELL PURPOSE: Home
(home, irrigation, municipal, industrial)

WELL COMPLETION DATA:

- (1) diameter (inches) 2"
- (2) total depth (feet) 60 ft.
- (3) static water level (feet) 12 below top of ground.
- (4) casing PVC, 60 (material) (depth)
- (size) If telescope see back.
- (5) screen 5 55 (length) (depth to top)
- 2" PVC (size) (material)
- (6) pump 1/2 6 (HP) (yield gpm)
- elect. (type power)
- (7) electric log (yes or no)
- (organization running log)

(8) how well bottom plugged sand SHARK


DRILLERS REMARKS: elect good

RECEIVED
JAN 10 1977

MISS. Bd. OF WATER COMMISSIONERS

If well telescopes please sketch and show depths.

GROUND LEVEL

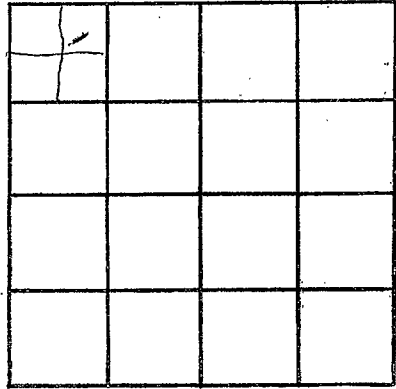

SECTION 2

Please indicate well location X.

ADDITIONAL INFORMATION

If more than one screen,
show locations of each on sketch.