

Marion
C 2005
6/23/77

MISSISSIPPI
BOARD OF WATER COMMISSIONERS
416 North State Street
Jackson, Mississippi 39201

WATER WELL DRILLERS LOG

6/23 1977 Hollinger MARION
date well completed firm name county well located

LANDOWNER: Bentley Smith description of formations encountered from to
1106 Hill St.
Columbia, Miss. COPEL CHALK 0 15
(mailing address) SAND, GRAVEL 15 60

WELL LOCATION:
sec. 23 T 5 N R 18 E
4 miles E of Bunker Hill
(distance) (direction) (nearest town)

WELL PURPOSE: Home
(home, irrigation, municipal, industrial)

WELL COMPLETION DATA:
(1) diameter (inches) 2"
(2) total depth (feet) 60
(3) static water level (feet) 15 below top of ground.
(4) casing PVC, 55
(material) (depth)
(size) if telescope see back.
(5) screen 5, 55
(length) (depth to top)
2", PVC
(size) (material)
(6) pump 1/2, 10
(HP) (yield gpm)
elect
(type power)
(7) electric log _____
(organization running log)
(8) how well bottom plugged sand
SHARK


DRILLERS REMARKS: very good

RECEIVED
JUL 11 1977

MISS. BD. OF WATER COMMISSIONERS

If well telescopes please sketch and show depths.

GROUND LEVEL

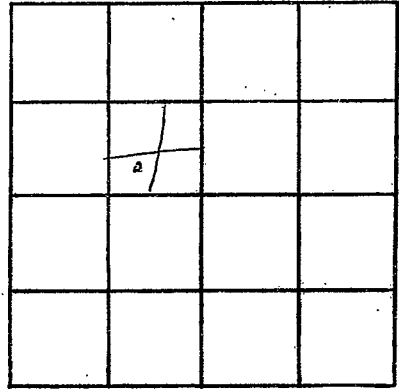

SECTION 23

Please indicate well location X.

ADDITIONAL INFORMATION

If more than one screen, show locations of each on sketch.