

Marion
C 2006
5/15/77

MISSISSIPPI
BOARD OF WATER COMMISSIONERS
416 North State Street
13V Jackson, Mississippi 39201

WATER WELL DRILLERS LOG

5/15 date well completed 1977 Hollinger Plumb Water firm name Marion county well located

LANDOWNER: Pete Breland
Rt 7 Box 295
Columbia Miss.
(mailing address)

description of formations encountered	from	to
C/ry	0	20
Chalk, sand	20	75
pebb. GRAVEL	55	75

WELL LOCATION:
sec. 19 T-5 (N) S R-18 E W
2 miles W of Budeville
(distance) (direction) (nearest town)

WELL PURPOSE: Home
(home, irrigation, municipal, industrial)

WELL COMPLETION DATA:

(1) diameter (inches) 2"

(2) total depth (feet) 75

(3) static water level (feet) 50 (below above top of ground)

(4) casing pvc, 70 (material) (depth)
(size) if telescope see back.

(5) screen 5, 70 (length) (depth to top)
2", pvc (size) (material)

(6) pump 3/4, 9 (HP) (yield gpm)
elect (type power)

(7) electric log (yes or no)

(organization running log)

(8) how well bottom plugged sand SHARIC


DRILLERS REMARKS: good well

RECEIVED
JUN 15 1977

MISS. BD. OF WATER COMMISSIONERS

If well telescopes please sketch and show depths.

GROUND LEVEL

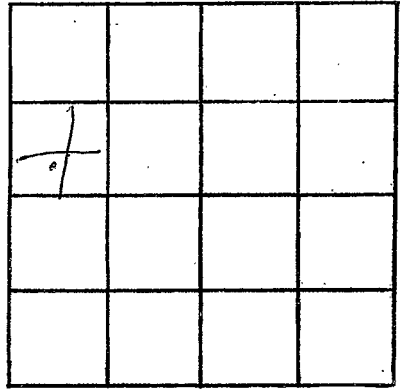

SECTION 19

Please indicate well location X.

ADDITIONAL INFORMATION

If more than one screen,
show locations of each on sketch.